

FRONT ELEVATION. (W.)

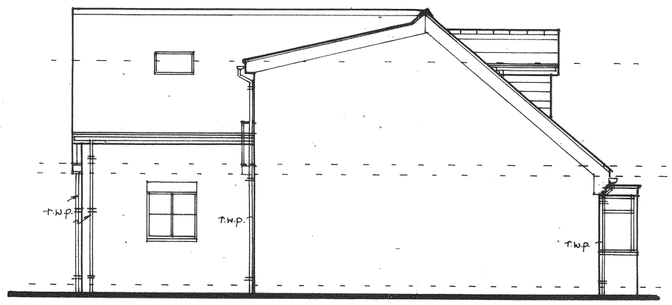

SIDE ELEVATION. (N.)

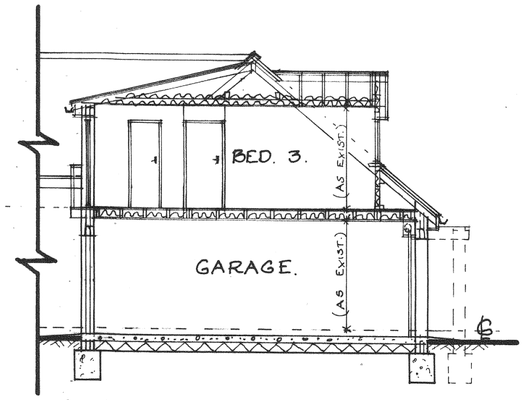

SECTION A:A.



REAR ELEVATION. (E.)

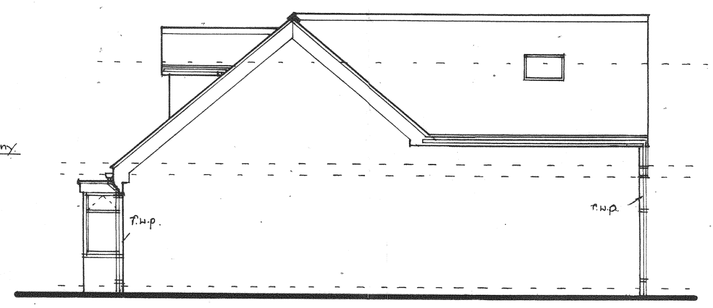

SIDE ELEVATION. (S.)

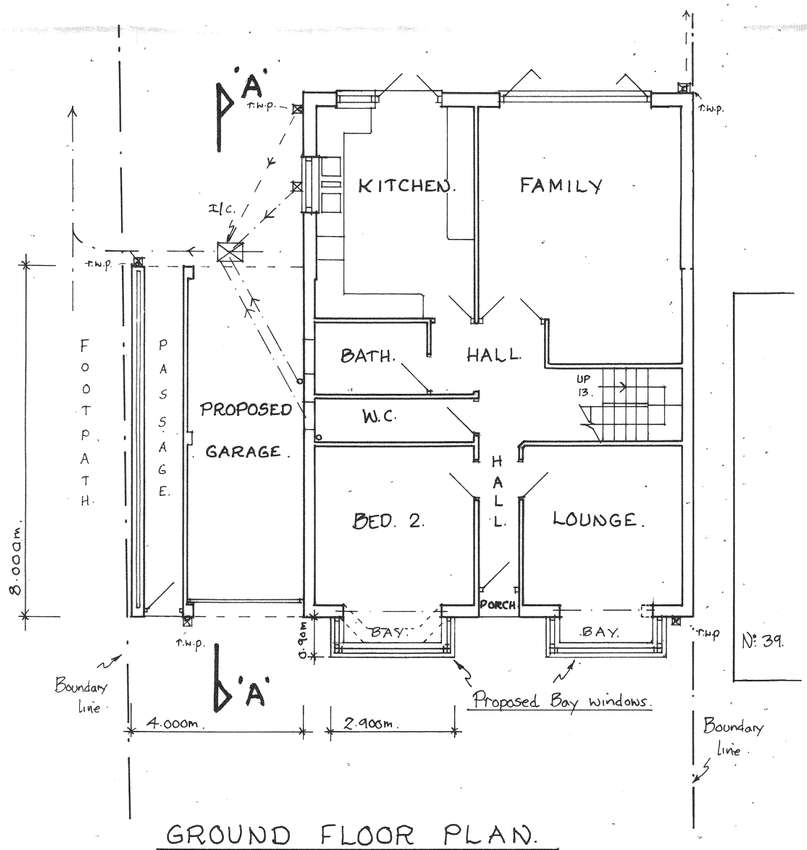

GROUND FLOOR PLAN.

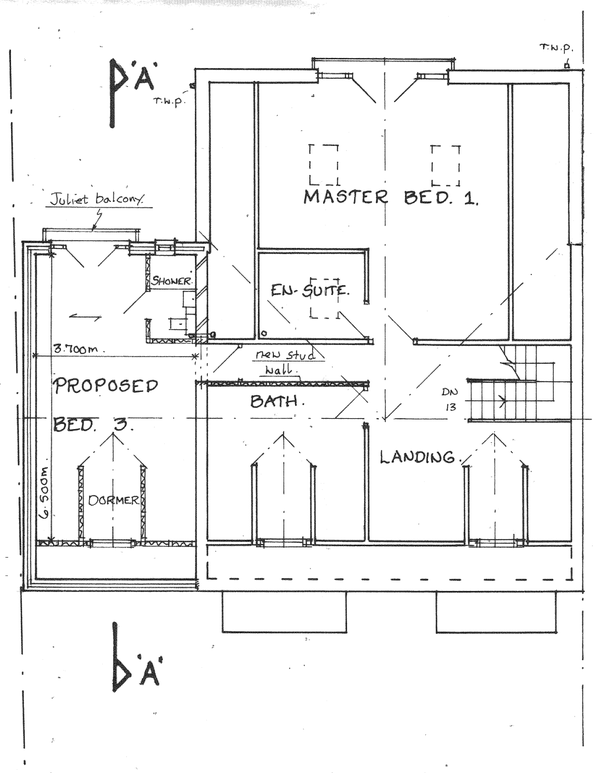

FIRST FLOOR PLAN.

Notes:
All dimensions must be checked on site and not scaled from this drawing.

	Date	Revisions
A	19-10-20	AS BUILT PHASE I SHOWN. EJO

© copyright

Client

MR. M. J. DUNNE.

Job Title

PROPOSED ALTERATIONS & SIDE EXTENSION TO A DETACHED BUNGALOW AT N°. 37 MAIN ROAD. SMALLEY, DERBY'S, DE7 6EF.

Drawing Title

PROPOSED. LAYOUTS.

Scale 1.100.

Date OCT.- 2020. Drawn by EJO

DICKINSON BUILDING DESIGN LTD.
BUILDING DESIGN CONSULTANTS
Domestic/Industrial/Commercial
Local Authority Approvals
Building Plans, Grants etc.
01332 831429
Mob. 07989 025551
E: dbdltd@btconnect.com
Rectory Lane
Breadsall, Derby
DE21 5LL

Drg. No. 06/10/2020/0 A

Rev. A 19/10/20 EJO

420 x 594mm A2.