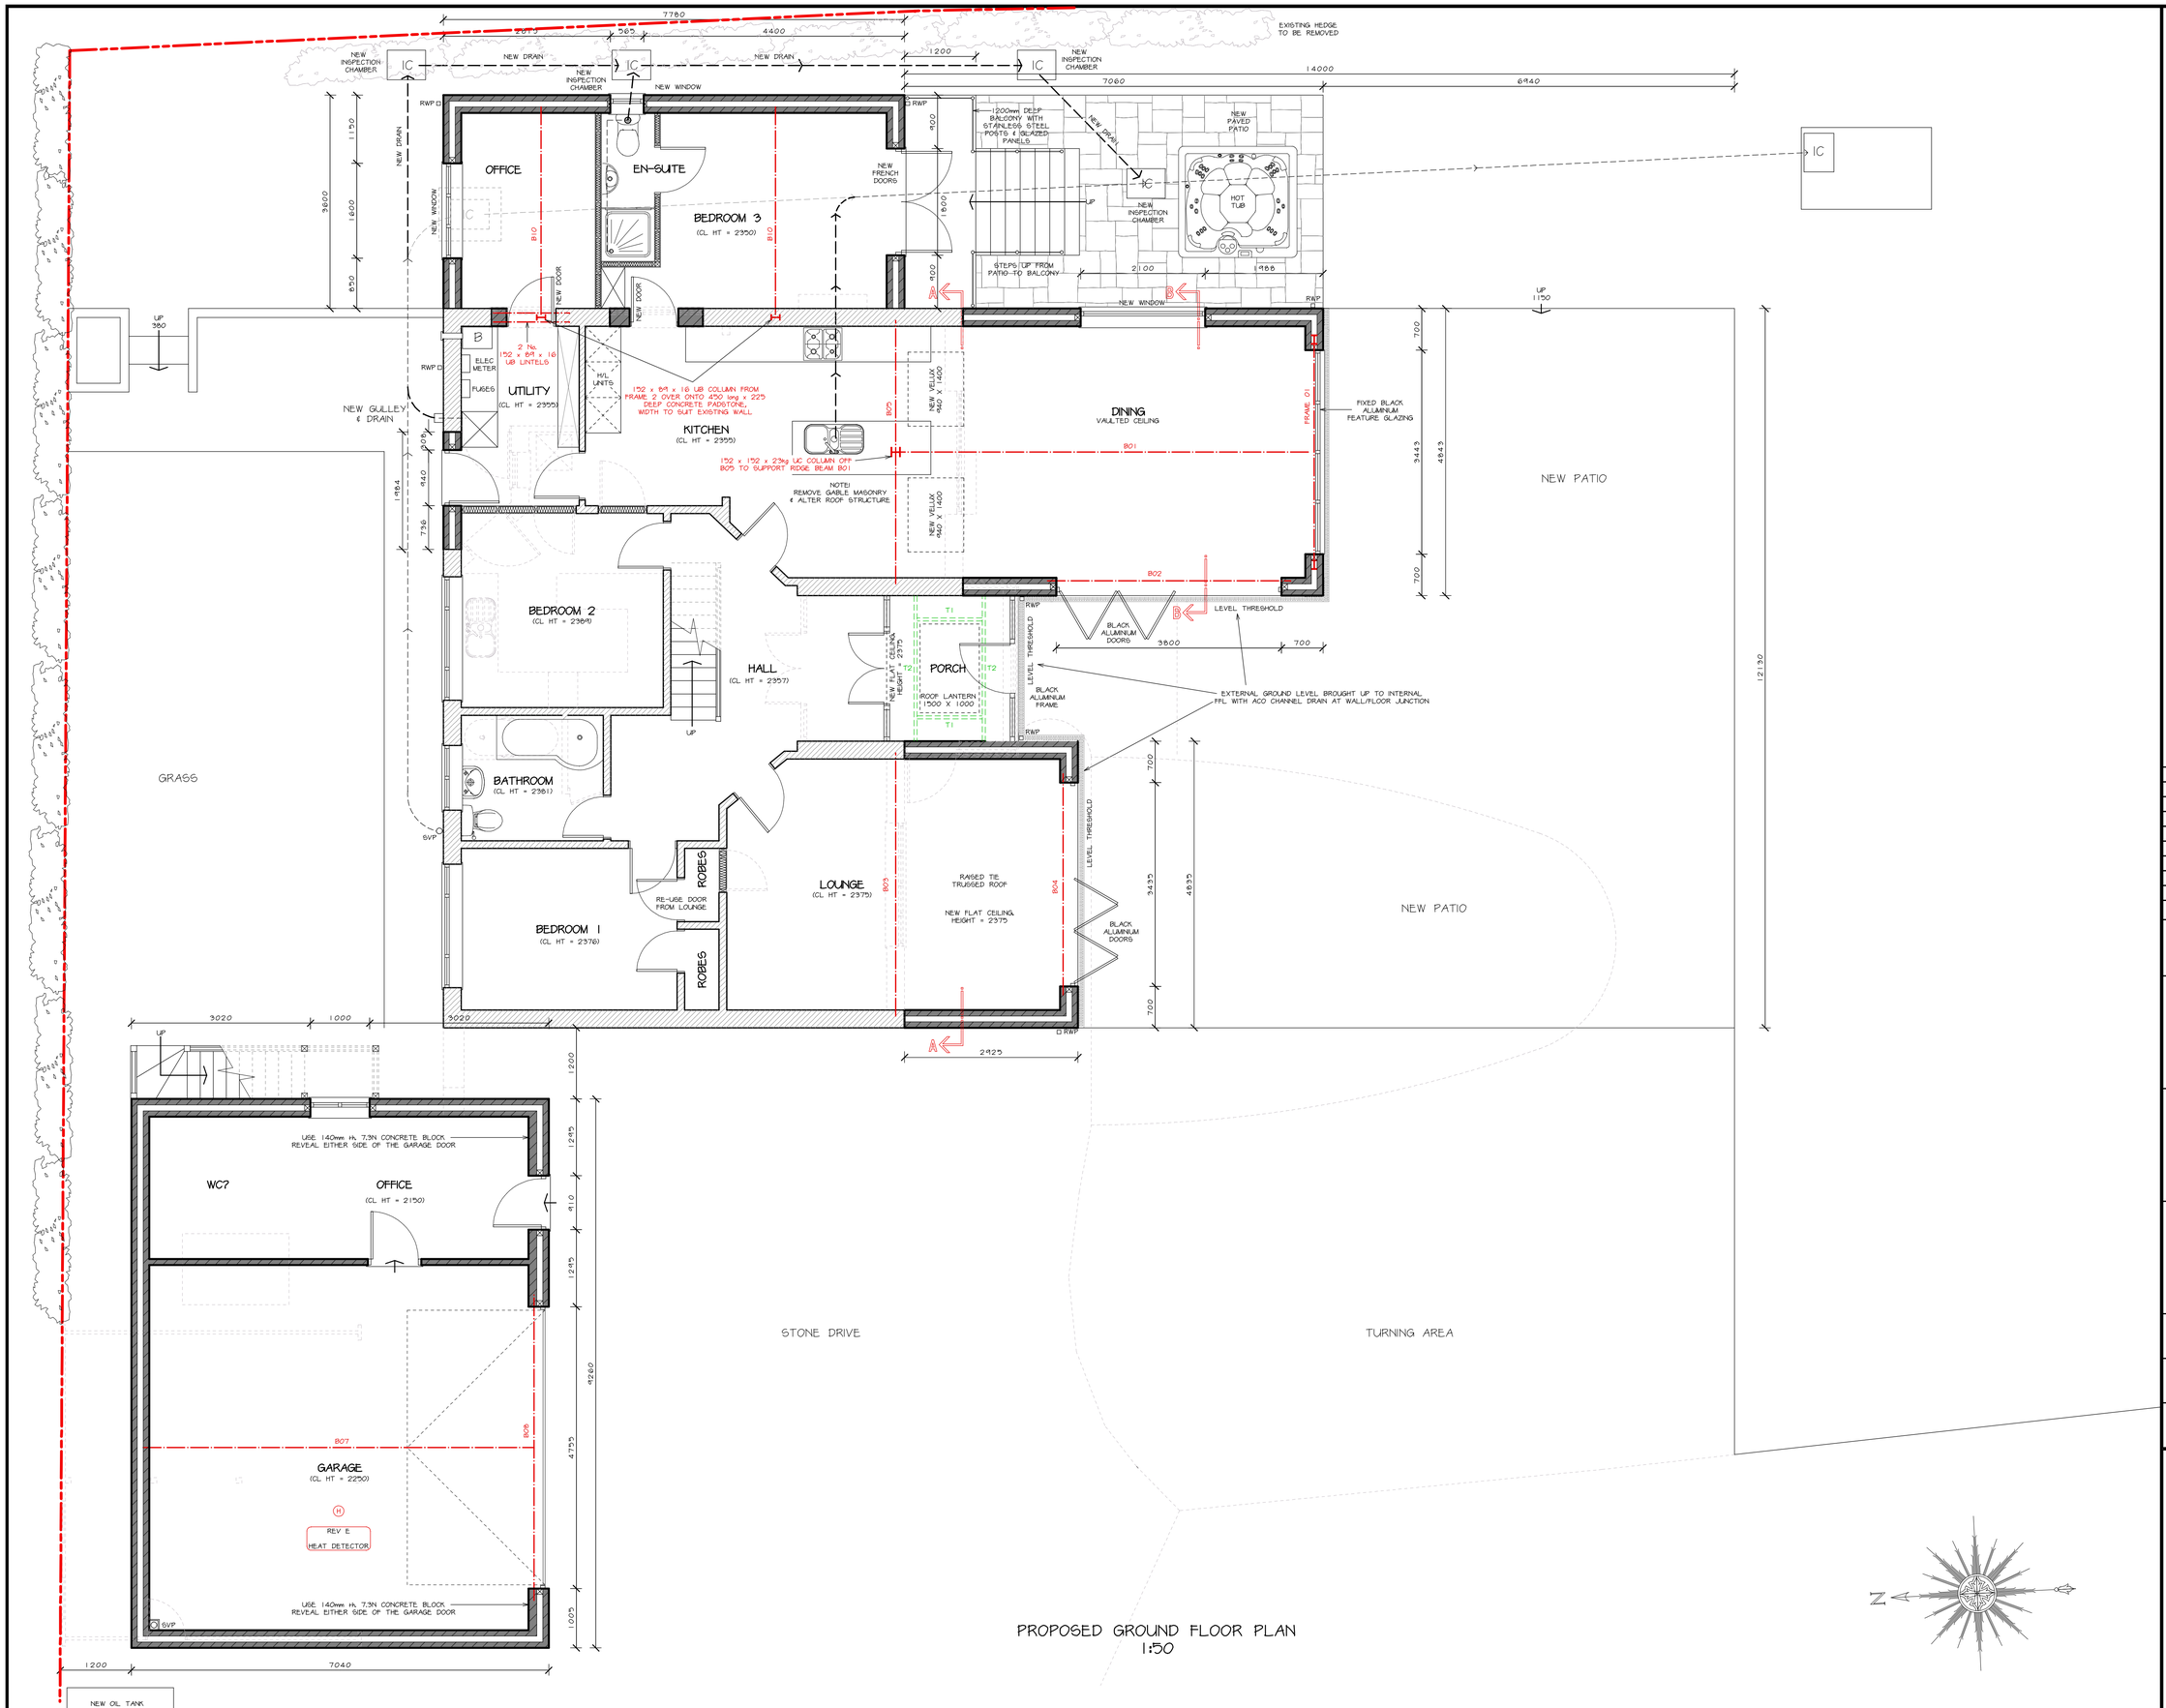

PROPOSED GROUND FLOOR PLAN
1:50

PAPER SIZE: A1

NOTES

All dimensions must be checked on site and only scaled from this drawing for planning purposes only

REV F

THIS DRAWING IS TO BE READ IN CONJUNCTION WITH THE STRUCTURAL CALCULATIONS PROVIDED BY BAYLISS CONSULTING REFERENCE "5345 MAY 2020" & ITS ASSOCIATED MARK-UP DRAWING "5345-01" & WITH THE FULL SPECIFICATION.

NOTE - DRAWINGS PROVIDED BY BAYLISS CONSULTING SUPERCEDE THOSE BY MAKING PLANS ARCHITECTURE

0 1 2 3 4 5
METRES (@ 1:100)

0 1 2
METRES (@ 1:50)

H	NOV 2020	DECKING REMOVED, SMALL BALCONY ADDED
G	SEP 2020	REAR & LHS BOUNDARIES CHECKED & AMENDED
F	MAY 2020	AMENDED FOR BUILDING CONTROL
E	MAY 2020	AMENDED FOR BUILDING CONTROL
D	APR 2020	AMENDED FOR BUILDING CONTROL
C	JAN 2020	AMENDMENTS FOR CLIENT
B	JAN 2020	AMENDMENTS FOR CLIENT
A	JAN 2020	AMENDMENTS FOR CLIENT
	Date	Revisions

© copyright

Client
MR & MRS GIBBON

Location
THE HOLLIES
BLUE BELL LANE
OFF ADAMS ROAD
KIRK LANGLEY
ASHBOURNE
DE6 4LW

Proposal
PROPOSED SINGLE STOREY EXTENSIONS TO FRONT AND SIDE OF PROPERTY & NEW DETACHED GARAGE WITH EN-SUITE BEDROOM OVER

Drawing Title
PRPOSED GROUND FLOOR PLAN

Scale
1:50

Date	Drawn by
JAN 2020	MRP

Drg No.	Revision
J2455-05	H

MAKING PLANS
architecture
Ivy Lodge, Twyford Road, Willington, Derby. DE65 6DE
T / F 01283 703160 E info@makingplans-architecture.co.uk
W www.makingplans-architecture.co.uk