

PROPOSED FRONT (S) ELEVATION
1:100

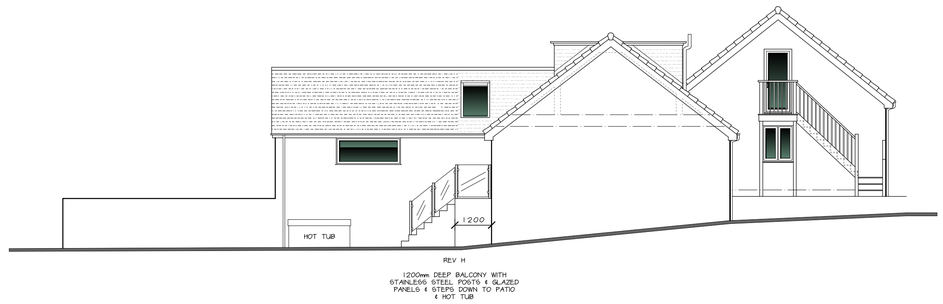

PROPOSED SIDE (W) ELEVATION
1:100

PROPOSED MATERIALS

CONCRETE INTERLOCKING ROOF TILES

FELT FLAT ROOF DORMERS WITH LIGHT GREY CEDRAL CLAD CHEEKS

BLACK UPVC FASCIA &

BLACK UPVC SQUARE RAIN WATER GOODS

WHITE K RENDER FINISH TO WALLS

BLACK UPVC WINDOWS

ALUMINIUM DOORS

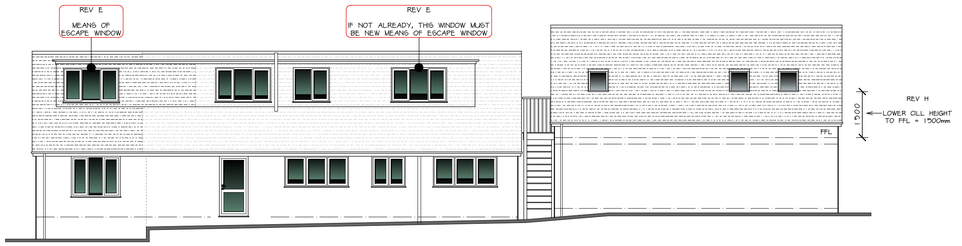

PROPOSED REAR (N) ELEVATION
1:100

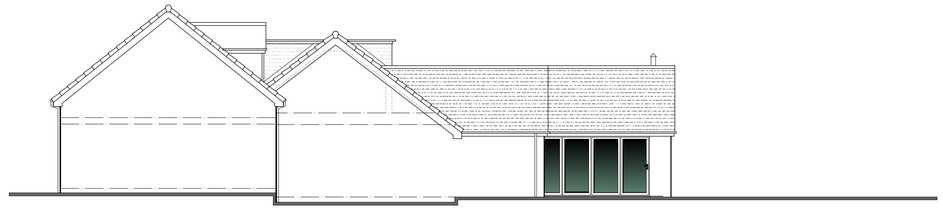

PROPOSED SIDE (E) ELEVATION
1:100

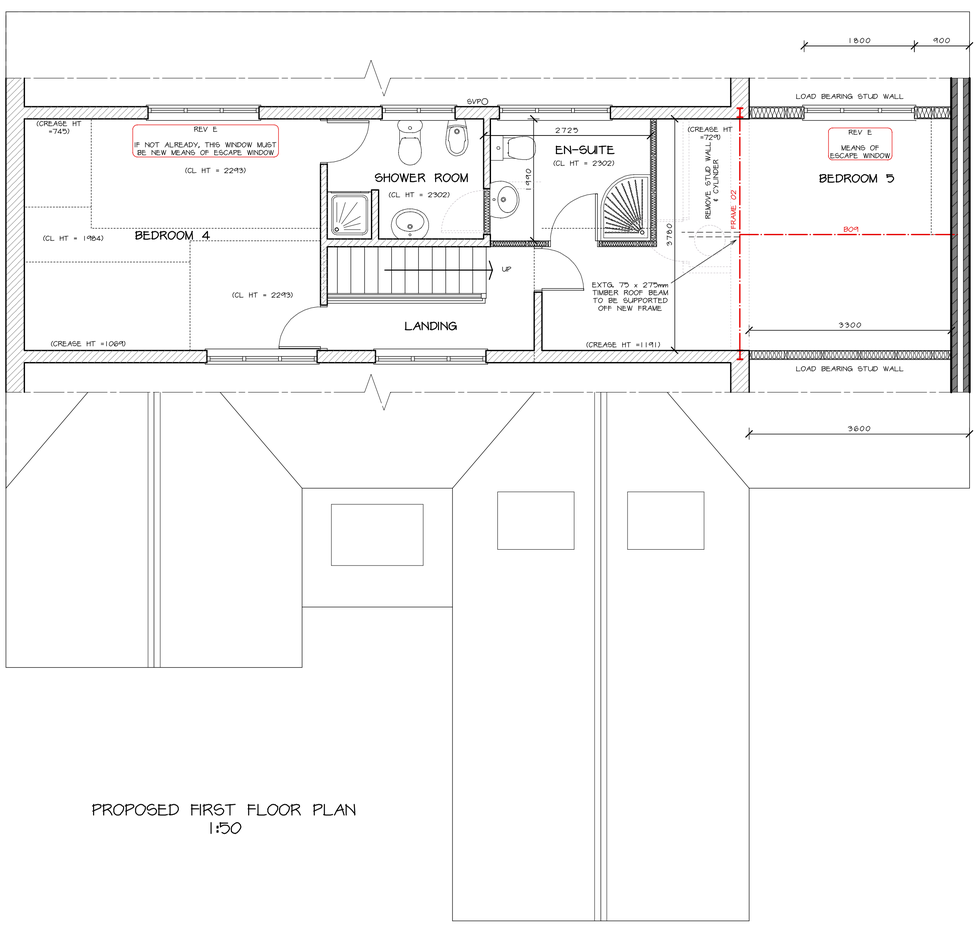

PROPOSED FIRST FLOOR PLAN
1:50

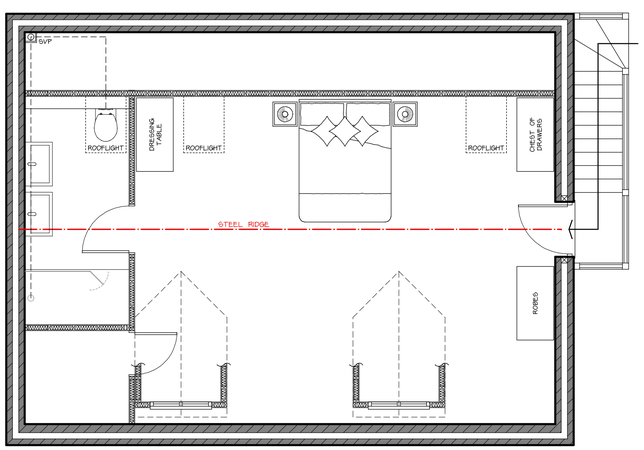

PROPOSED GARAGE FIRST FLOOR PLAN
1:50

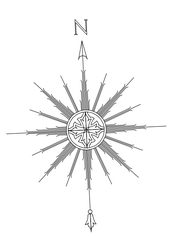

PAPER SIZE: A1

NOTES

All dimensions must be checked on site and only scaled from this drawing for planning purposes only

REV F

THIS DRAWING IS TO BE READ IN CONJUNCTION WITH THE STRUCTURAL CALCULATIONS PROVIDED BY BAYLISS CONSULTING REFERENCE "9345 MAY 2020" & ITS ASSOCIATED MARK-UP DRAWING "9345-01" & WITH THE FULL SPECIFICATION.

NOTE - DRAWINGS PROVIDED BY BAYLISS CONSULTING SUPERCEDE THOSE BY MAKING PLANS ARCHITECTURE

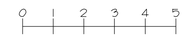



	Date	Revisions
H	NOV 2020	DECKING REMOVED, SMALL BALCONY ADDED
G	SEP 2020	FOOTPRINT OF NEW GARAGE ENLARGED
F	MAY 2020	AMENDED FOR BUILDING CONTROL
E	MAY 2020	AMENDED FOR BUILDING CONTROL
D	APR 2020	AMENDED FOR BUILDING CONTROL
C	JAN 2020	AMENDMENTS FOR CLIENT
B	JAN 2020	AMENDMENTS FOR CLIENT
A	JAN 2020	AMENDMENTS FOR CLIENT

© copyright

Client

MR & MRS GIBBONS

Location

THE HOLLIES
BLUE BELL LANE
KIRK LANGLEY
ASHBOURNE
DE6 4LW

Proposal

PROPOSED SINGLE STOREY EXTENSIONS TO FRONT AND SIDE OF PROPERTY & NEW DETACHED GARAGE WITH EN-SUITE BEDROOM OVER

Drawing Title

PROPOSED FIRST FLOOR PLAN & ELEVATIONS

Scale

1:50 & 1:100

Date	Drawn by
JAN 2020	MRP

Drg No.	Revision
J2955-06	H

MAKING PLANS
architecture

Ivy Lodge, Twyford Road, Willington, Derby. DE65 6DE
T/F 01283 703160 E info@makingplans-architecture.co.uk
W www.makingplans-architecture.co.uk