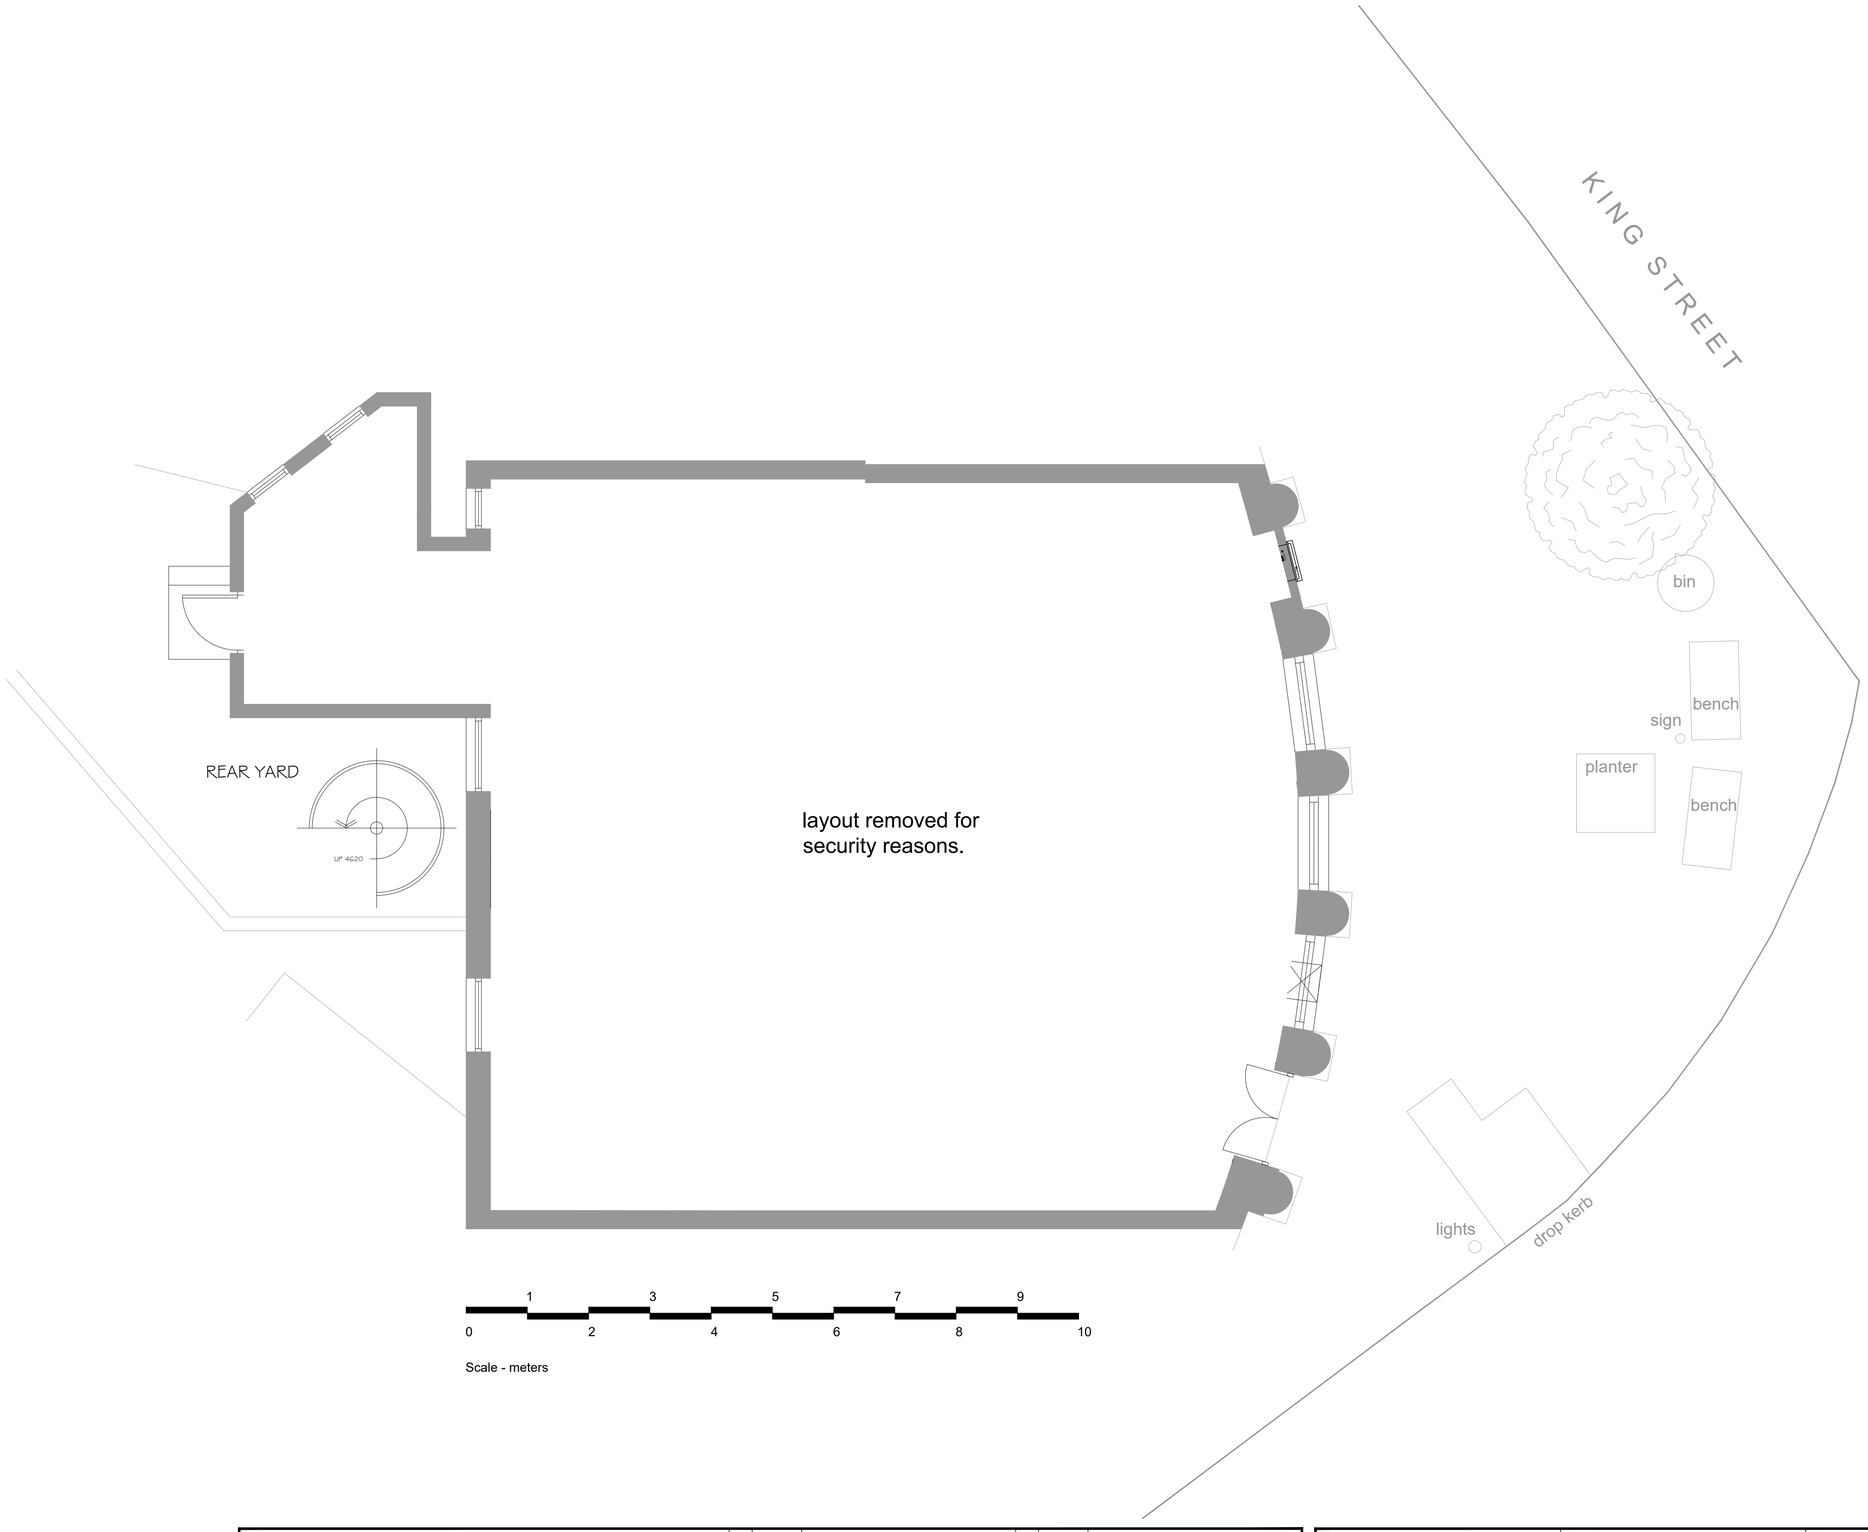


Notes:	Rev	Date	Notes	Rev	Date	Notes
Copyright of this drawing is reserved by AXIS Architecture and issued on the condition that it is not copied, reproduced or disclosed to any third party either wholly or in part without the consent in writing of AXIS Architecture. The contractor must verify all dimensions on site before making shop drawings or commencing work of any kind. No dimensions to be scaled from this drawing. **RESIDUAL RISK** Wherever possible unnecessary risk is designed out of these proposals. Where residual risk remains this is assessed and identified on the relevant drawings with this symbol. Refer to the note and the relevant measures in the Health + Safety documentation						

Client	Project	Title
Corporate Real Estate	Project Abbey Belper	Existing Plans Ground Floor

Status	Scale A1	Scale A3	Date	Drawn	Checked	Job No.	Revision
RECORD DRAWING	1:50	1:100	15.04.21	LDD	RAS	27622-006-GF-EX-PL1	-

AXIS Architecture and Design Ltd,
Talbot Chambers,
2-6 North Church Street,
Sheffield, S1 2DH.
tel: +44(0)114 2490944
fax: +44(0)114 2490966
www.axis-architecture.com
designed@axis-architecture.com

AXIS architecture

PUBLIC