General Notes

Do not scale off this drawing for construction purposes

All dimensions and heights to be confirmed on site prior to commencement

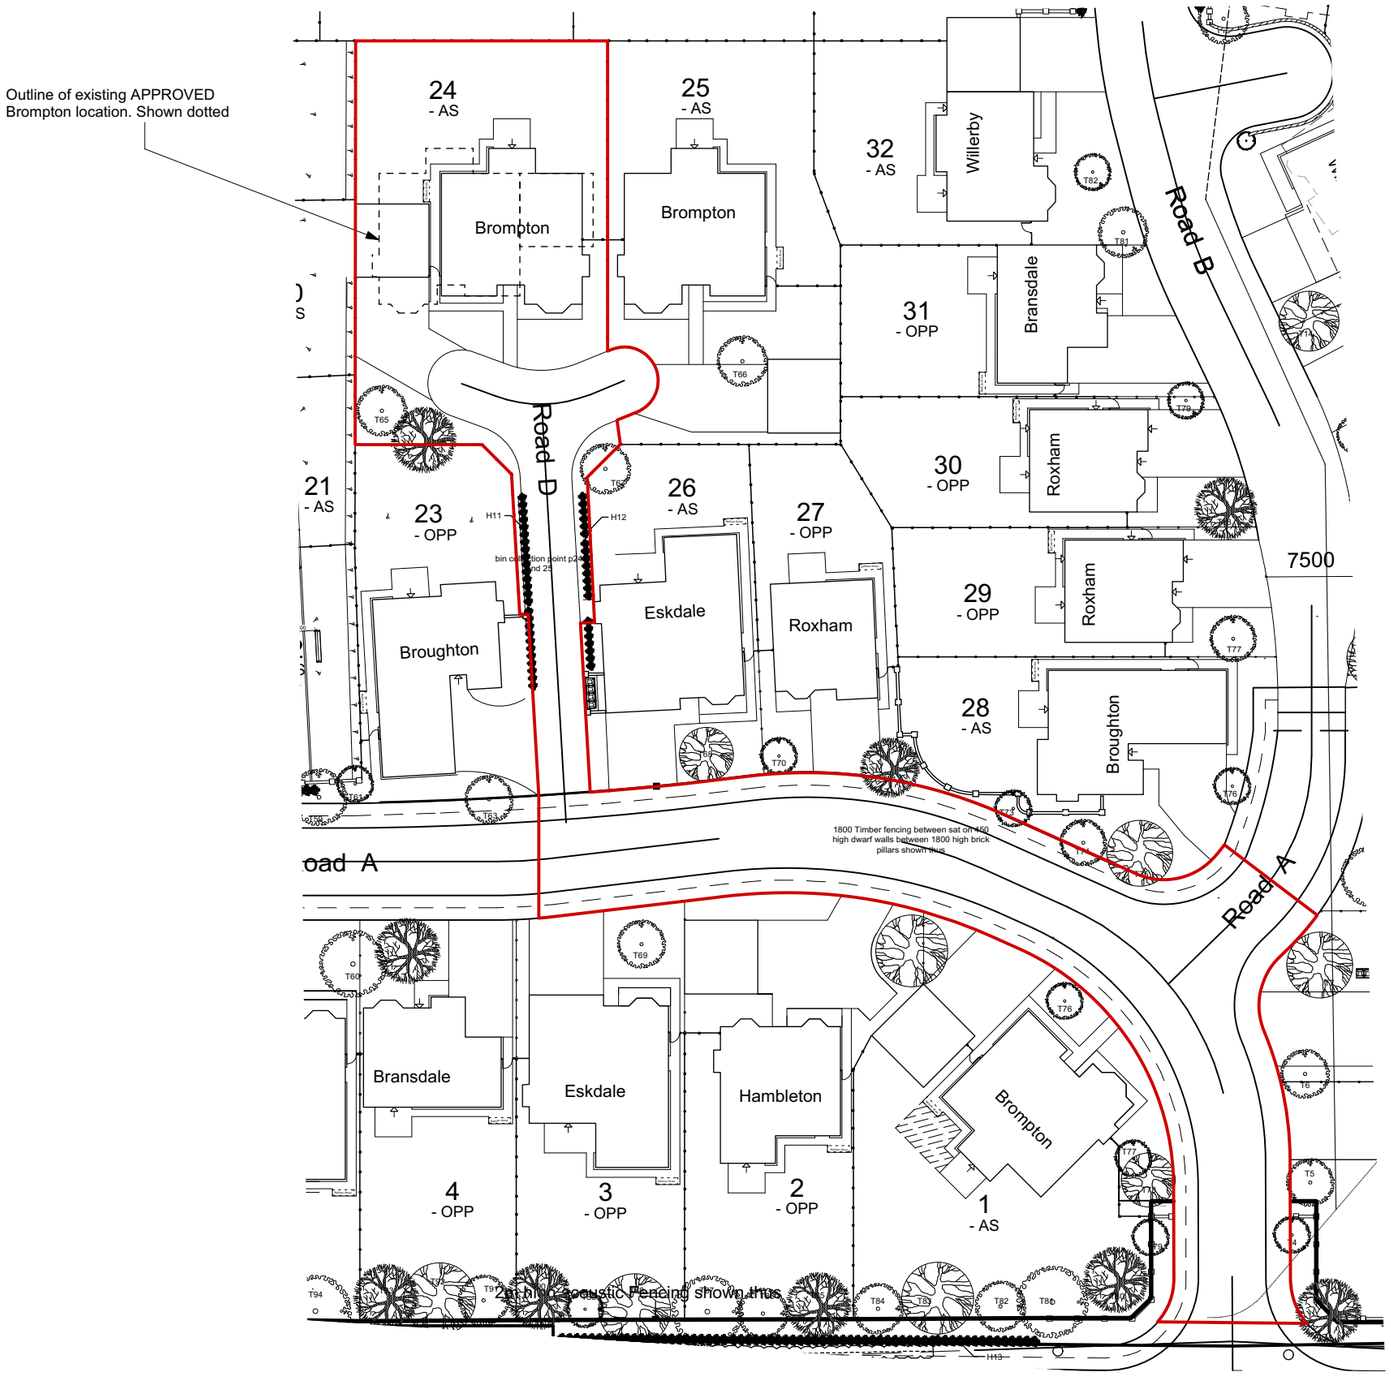

BLOCK PLAN

PLANNING

0: 11-05-21 First issue

Revisions

fairgrove

BRIDGE HOUSE
HARDY CLOSE, KIMBERLEY, NOTTINGHAMSHIRE, NG16 2JW
T: 0115 944 6700 F: 0115 9446701 WWW: fairgrove.co.uk

Project

SLEETMOOR LANE
SWANWICK
DERBYSHIRE

Drawing title

PLOT 24 ONLY
BROMPTON - HANDED PLOT

Preliminary	For Construction	As Built
Planning Issue	Building Reg. Issue	Contract Issue

© The contents of this drawing may not be reproduced in whole or in part without the written permission of Fairgrove Developments Limited

Scale	Date	Drawn by	Checked by
1:200@A3	MAY 21	cs	

Job No.	Dwg. No.	Rev.
064	BROM/P/03	0

©copyright