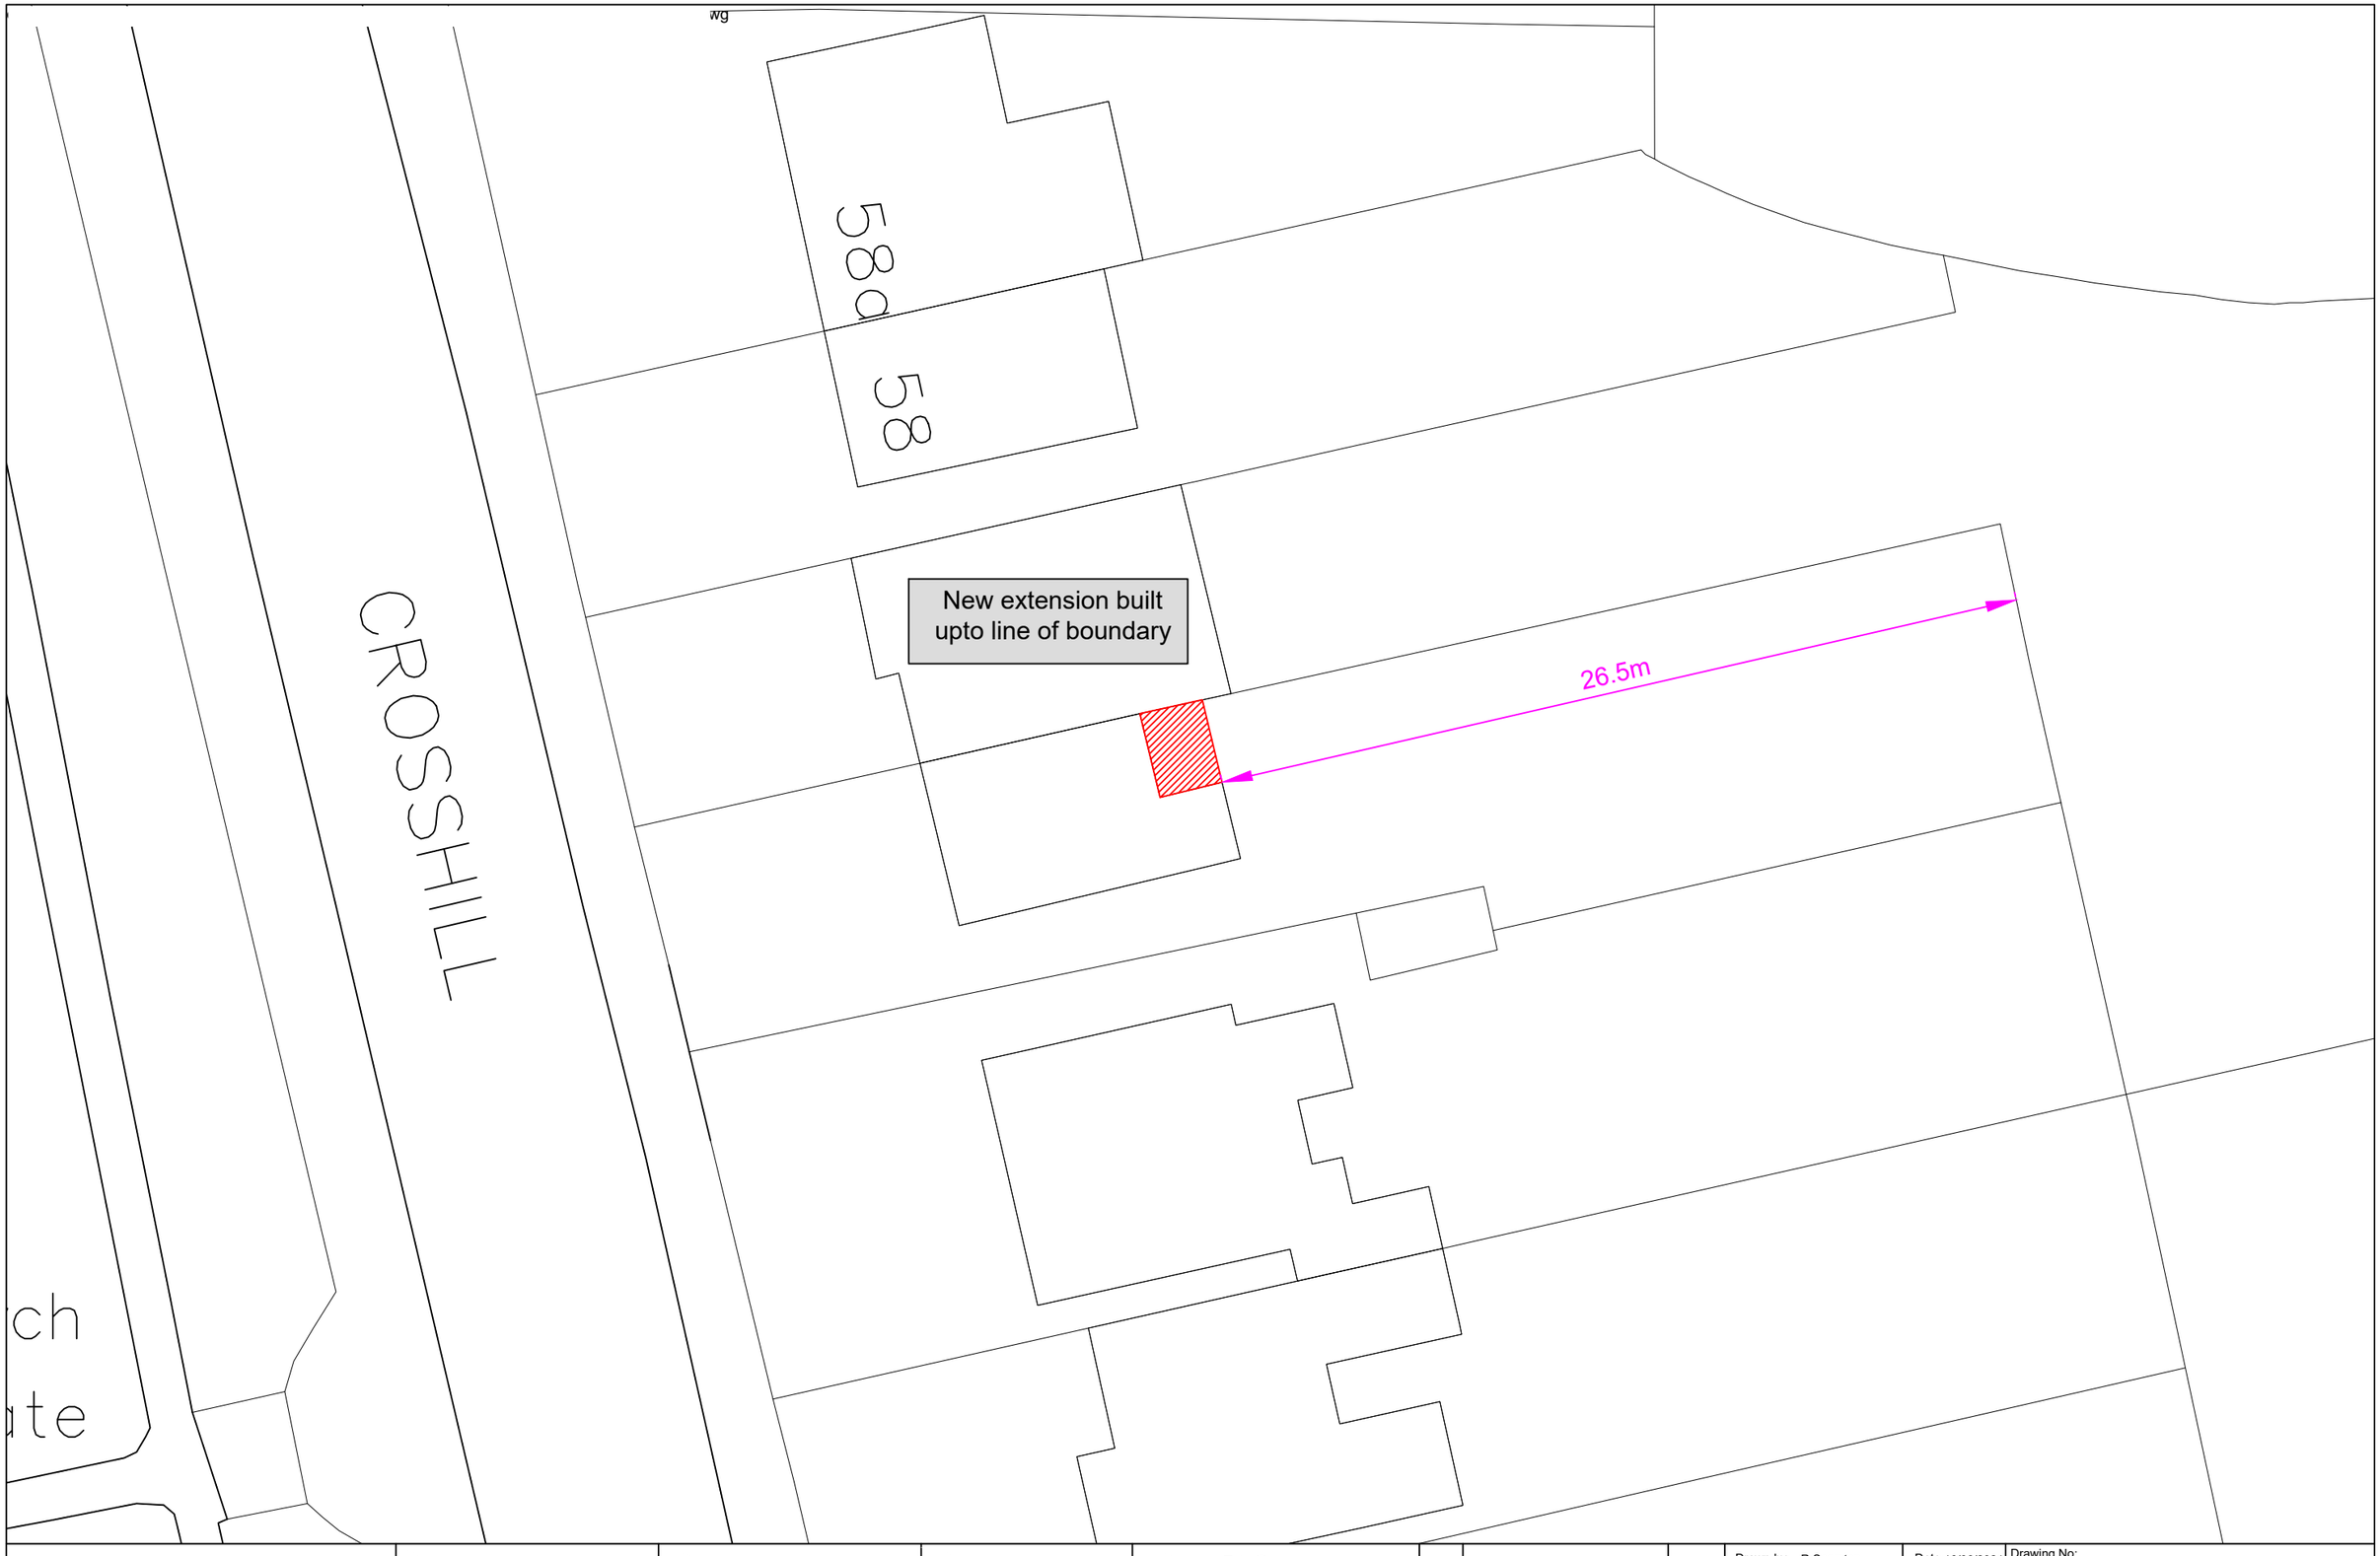


54 Crosshill
BUILDING CONTROL
DRAWINGS
(Block Plan)

Rev No	Details	Date

Drawn by: R.Searston | Date:16/06/2021

Approved by: | Date:

2021
This drawing may not be copied, modified or used for any other purpose other than that for which it is intended without the permission of RS Traffic Management Design.

Drawing No:
Block Plan OS Tile

Status: ■ For Comment ☐ For Issue ☐ As Built

Sheet No: 1 of 1

Original size: A1 Scale: 1:200