FIG 4

MARKED UP SECTION THROUGH CURB SHOWING WORKS TO CURB AND GUTTER March 2022

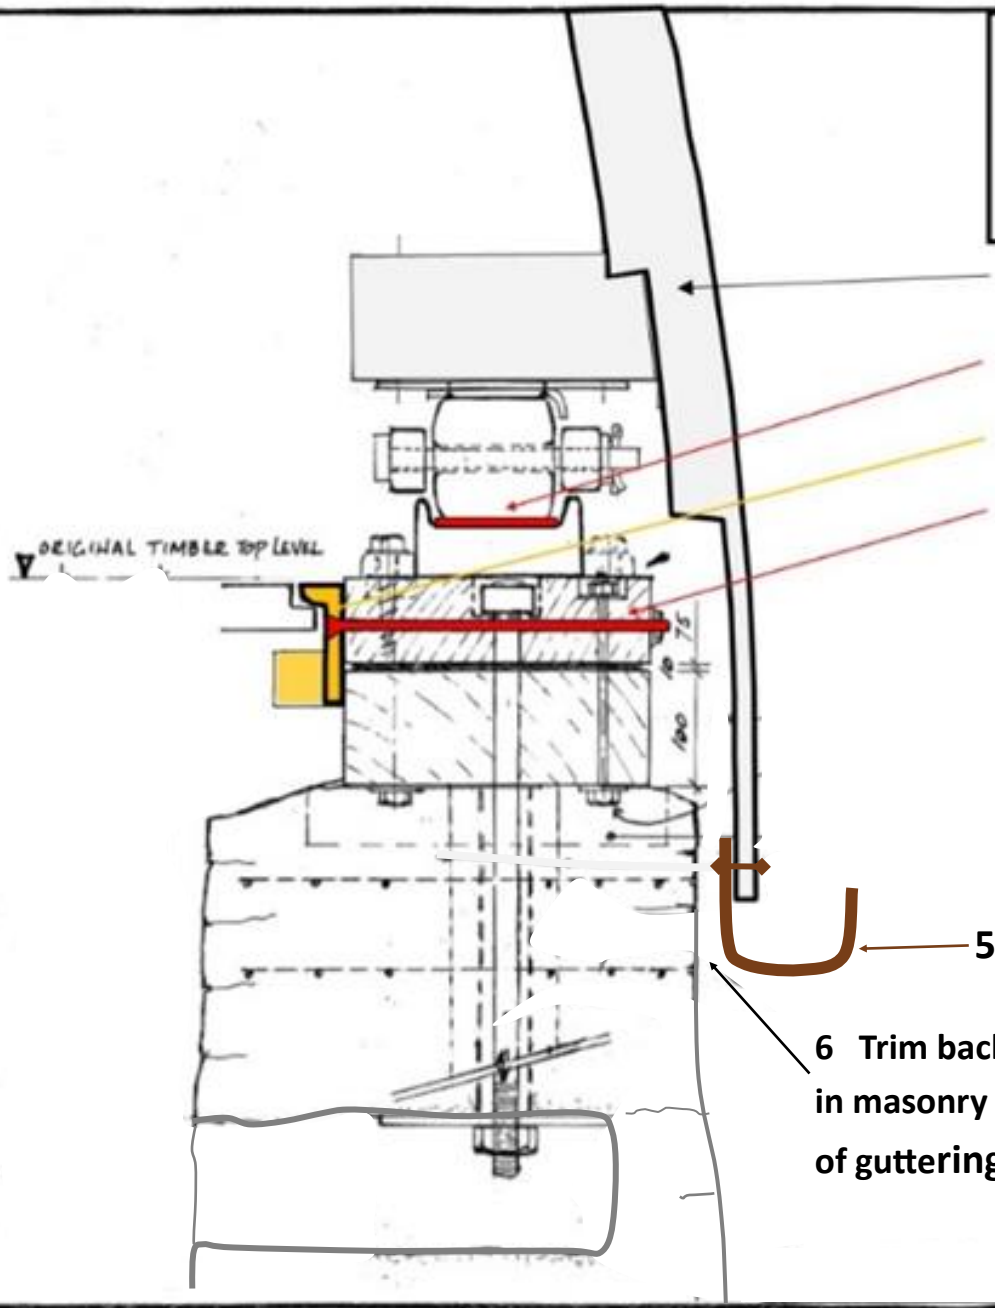

1 Temporarily remove cap to provide access

2 Insert annular running plate into curb channel

3 Refix cast iron ring gear

4 Replace fixing bolts

5 Renew gutter

6 Trim back random small projections in masonry to prevent abrasion of back of guttering.

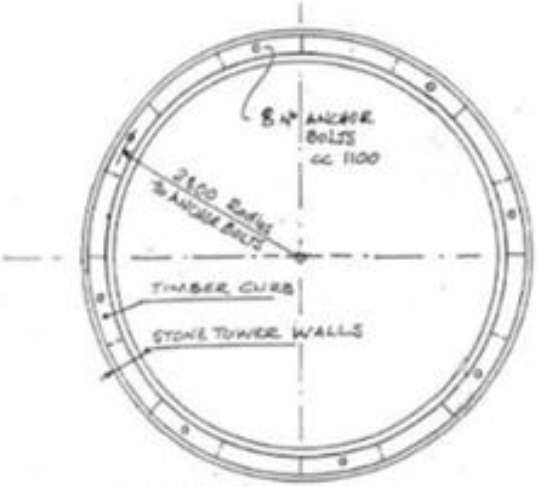

KEY PLAN (DIAGRAMMATIC)

REV A: BOLTS CHANGED 7/6

DERBYSHIRE COUNTY COUNCIL and the HEAGE WINDMILL SOCIETY	HEAGE WINDMILL RESTORATION Details of new curb	BOUCHER & SONS Chartered Engineers And Consultant...Millwrights Westwood Farm, Main Road, Westwood, Notts, NG16 5HU Telephone and Fax: 01773 602594	Scale: 1:5 & 1:20 Drawn: JEB Date: MAY '99 Drg no. 39.04A