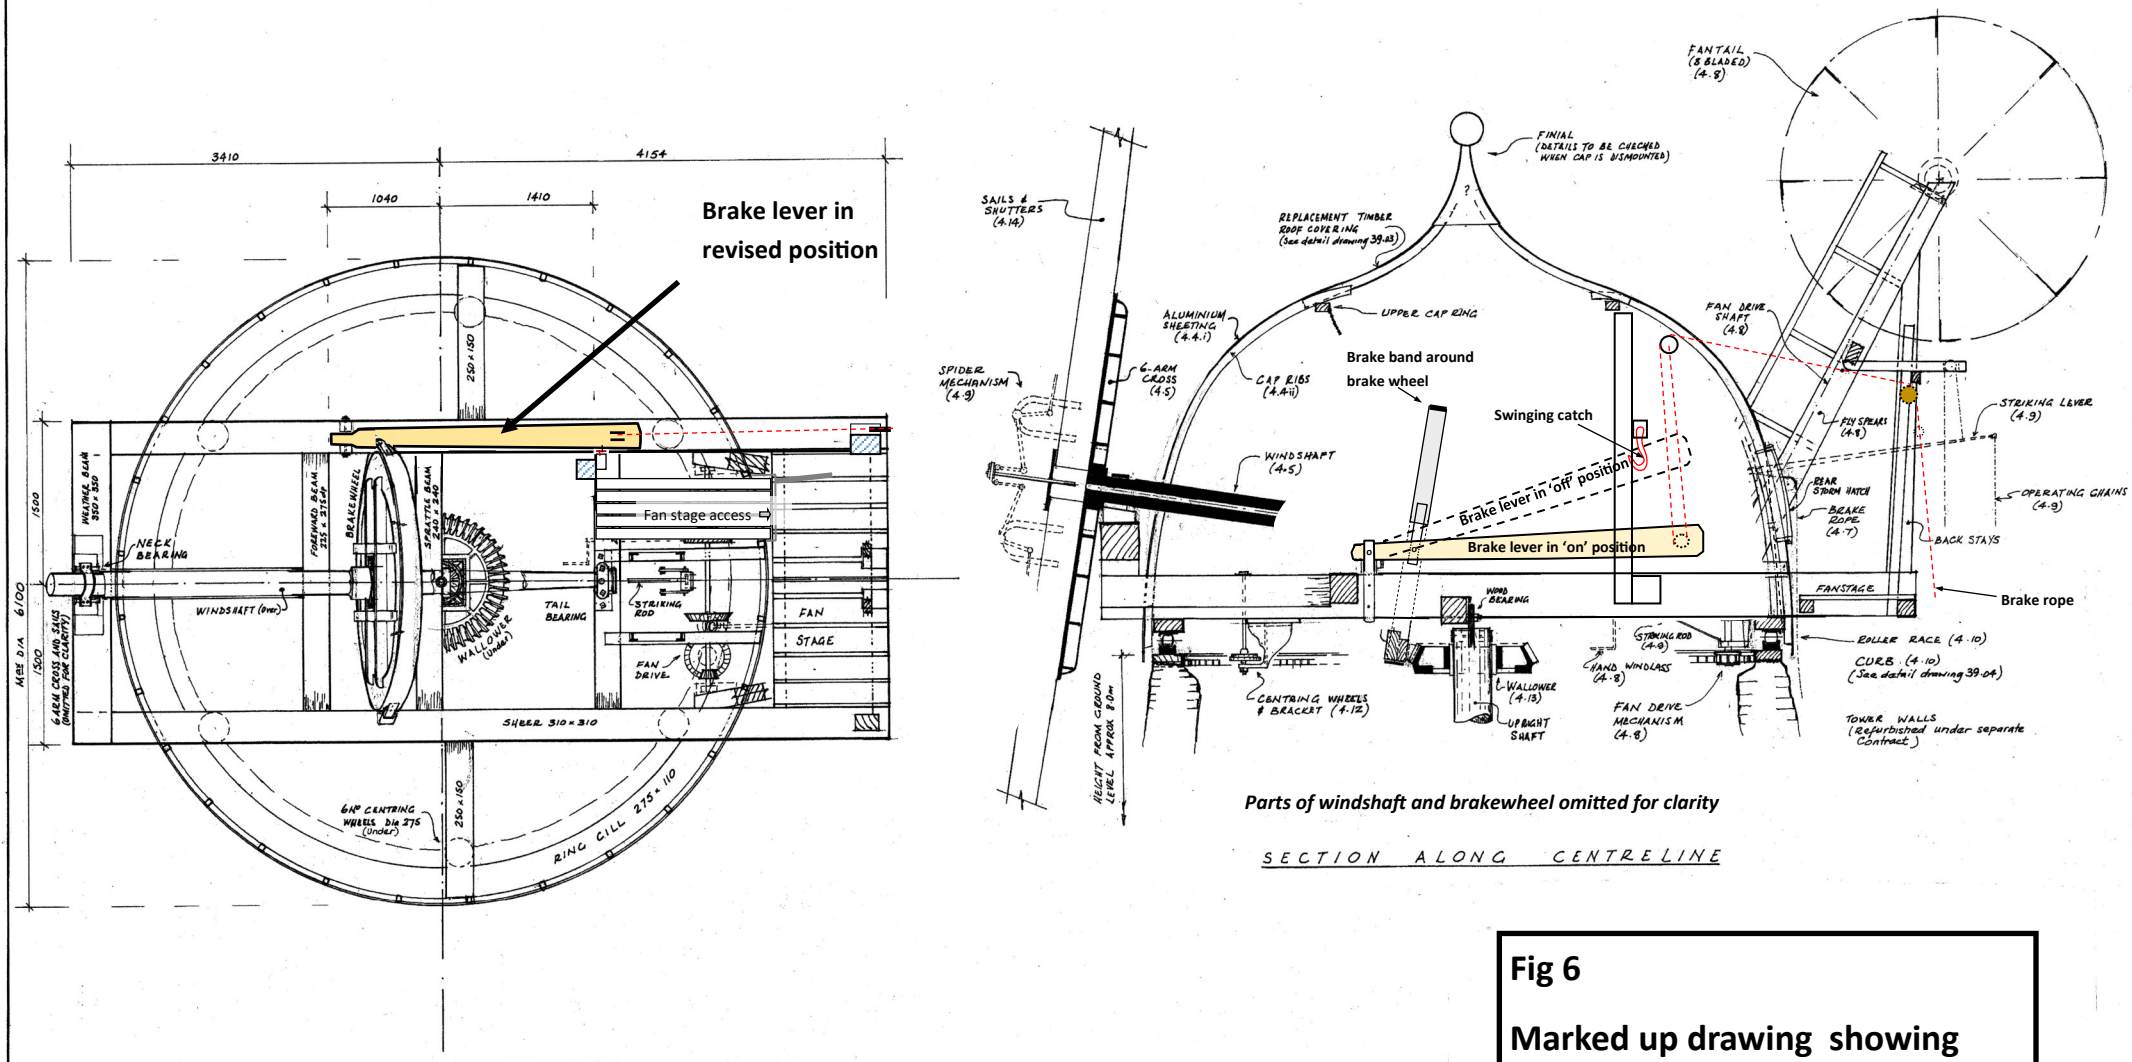

Fig 6

Marked up drawing showing proposed location for new brake lever.

JKGB 14.02.22

DERBYSHIRE COUNTY COUNCIL and the **HEAGE WINDMILL SOCIETY**	***HEAGE WINDMILL RESTORATION*** ***General Arrangement of Cap***	**BOUCHER & SONS** Consultant Millwrights Westwood Nottinghamshire NG16 5HU Tel/fax 01773 602594	Scale : 1:50 AT SIZE A3 Drawn: J.K.G.B. Date : May 1999 **Drg no. 39.02**