



FRONT (WEST) ELEVATION

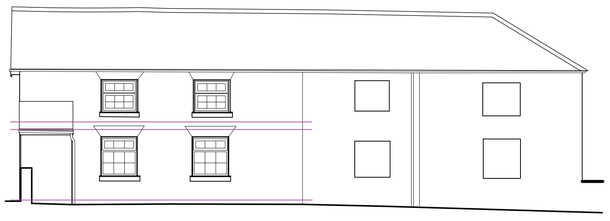


SIDE (NORTH) ELEVATION




SIDE (SOUTH) ELEVATION

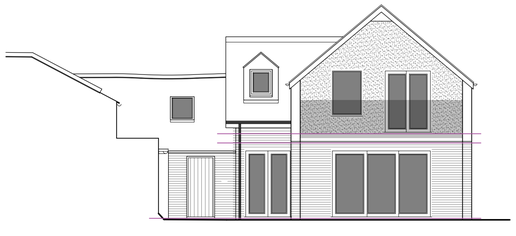

REAR (EAST) ELEVATION

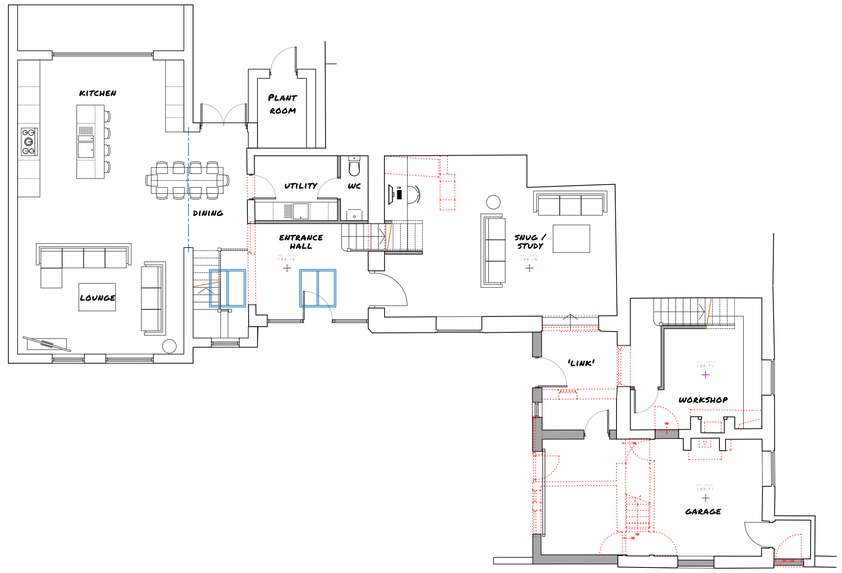

GROUND FLOOR PLAN

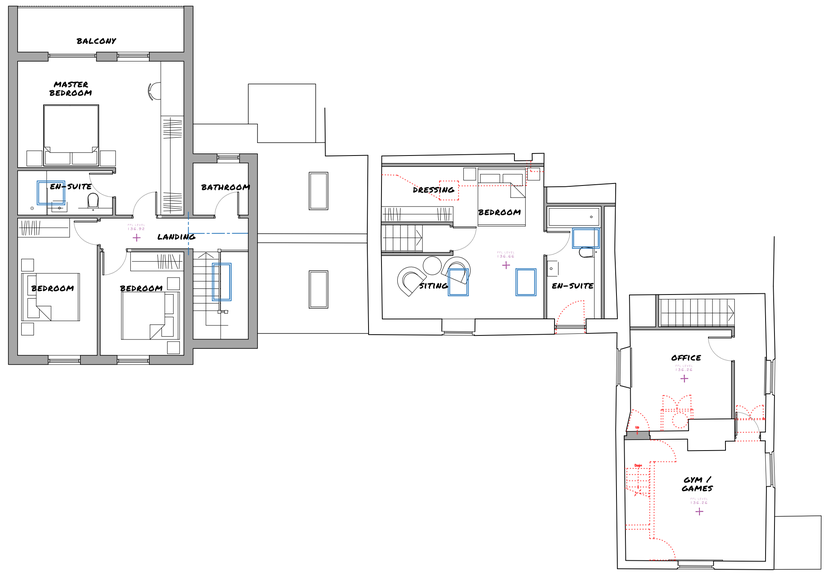

FIRST FLOOR PLAN

Revisions:

Rev C, 28.03.2022, Various as-built alterations

GREY RICHARDS TROWELL ARCHITECTURE

Address: 1-3 Greenhill, Wirksworth, Derbyshire, DE4 4EN
Tel: 01629 825491
Email: info@grtarchitecture.co.uk
Website: www.grtarchitecture.co.uk

Client:	Patrick Greensmith		
Project:	Extension & Alterations		
Address:	91 Main Road Smalley ILKESTON DE7 6DS		
Drawing:	As Proposed		
Dwg No:	002	Date:	15/07/2021
Scale:	1:100	Paper size:	A1
RIBA Stage:	003		

Please Note:

Drawings up to RIBA Work Stage 4 are not sufficiently detailed for construction

DO NOT SCALE DRAWING

© Grey Richards Trowell Architecture all rights reserved