



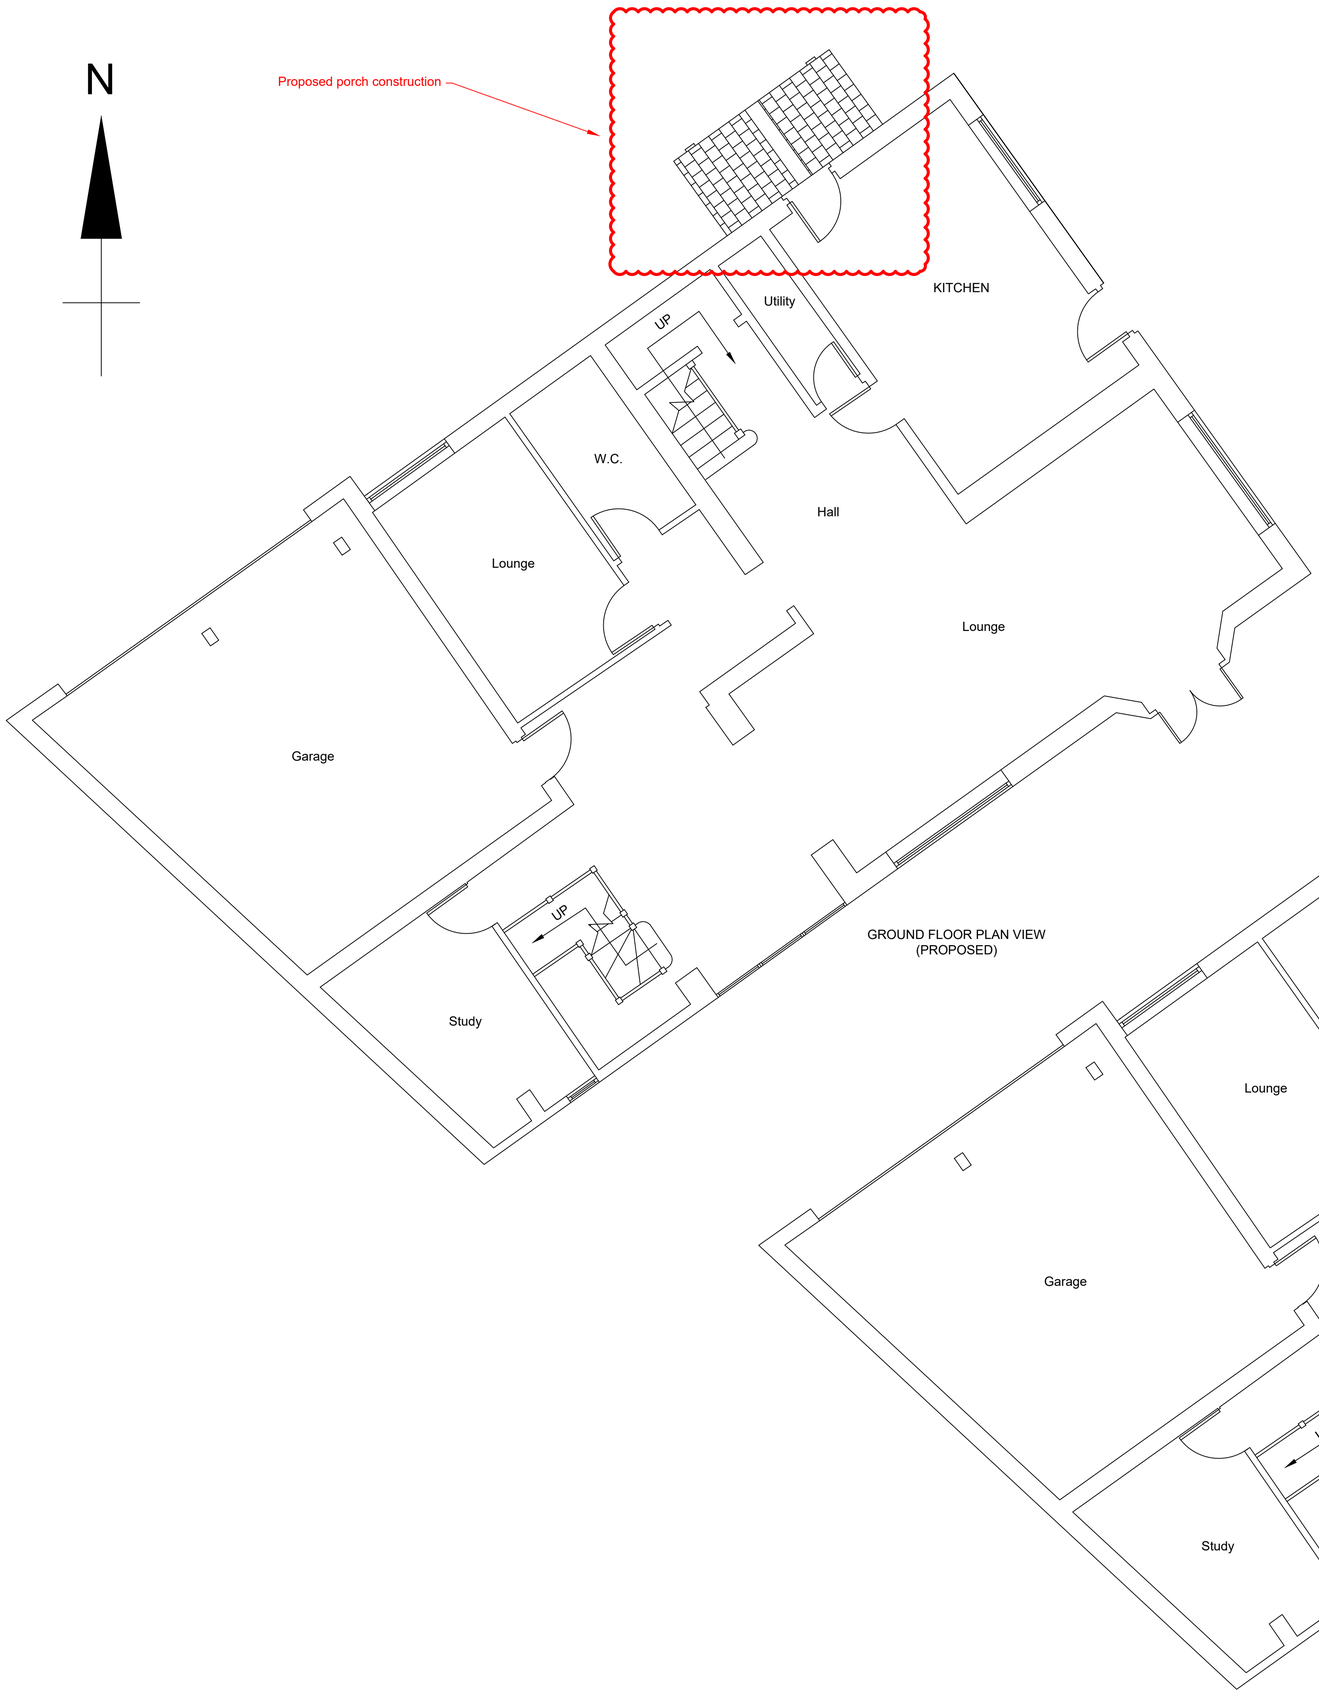

AS-BUILT DETAIL

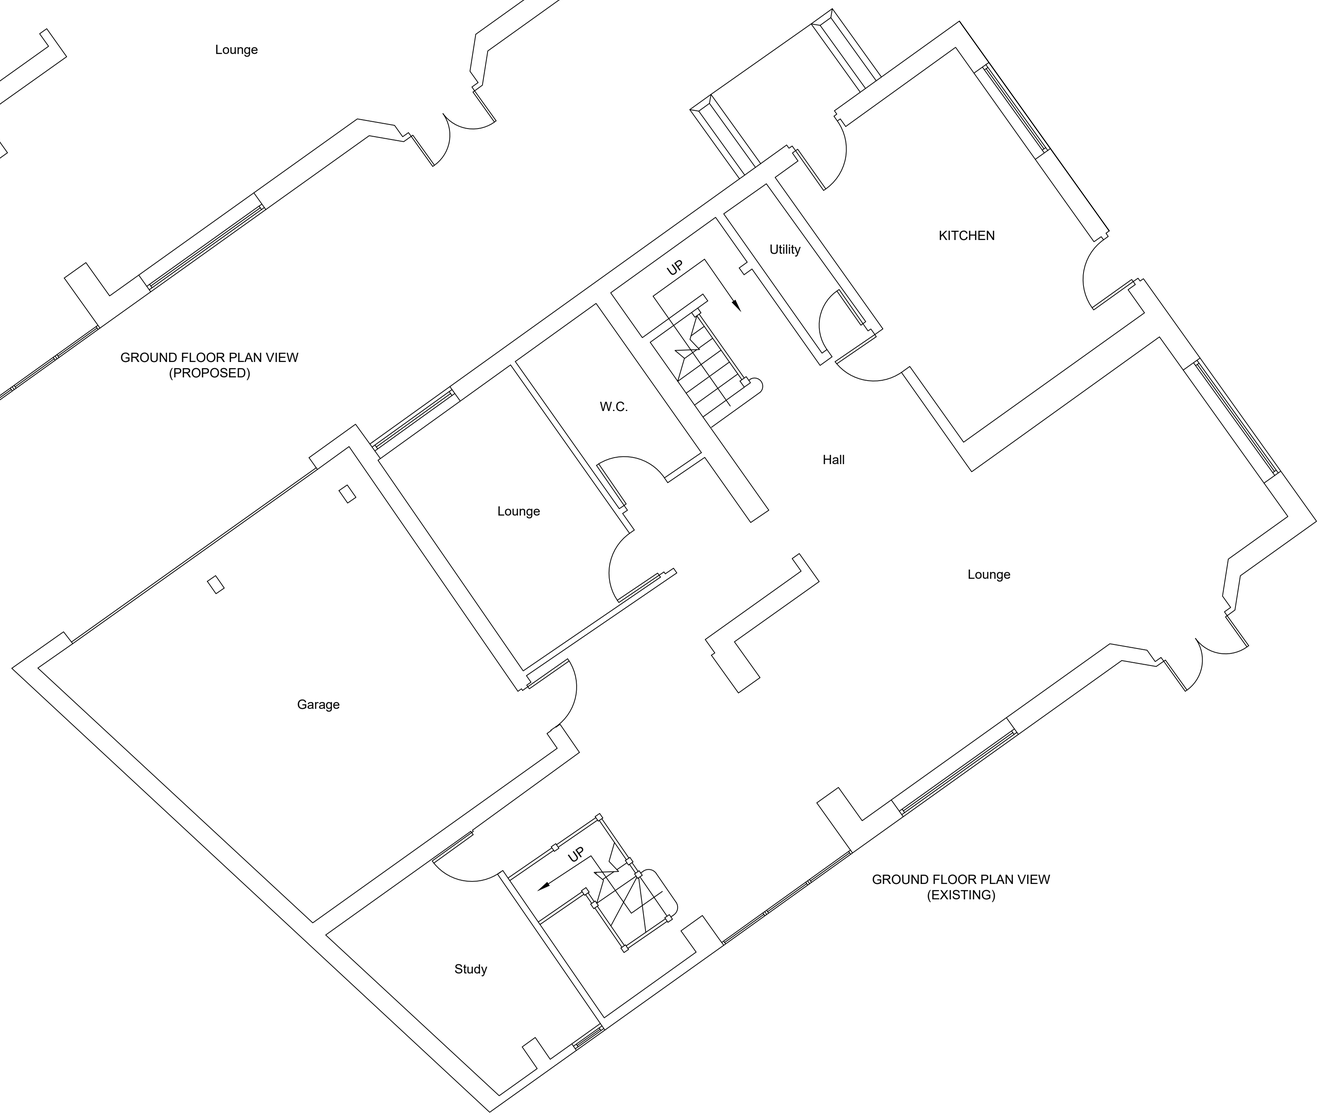

NOTES

Proposed Materials

- Green oak truss, posts, rafters and wall plate
- Lead flashing and apron
- Felt and battened clay tile roof

Existing Materials (see AS-BUILT DETAIL)

- Oak effect UPVC front door
- Cream coloured silicon render to external walls
- Rustic brick stub wall with buff coloured natural stone effect concrete coping
- Stone floor slabs

Proposed Oak Porch Construction
59 Lockton Avenue, Heanor,
Derbyshire, DE75 7ER

Scale: 1/50
Sheet: A1
Author: Richard Martin
Date: 08/04/2022