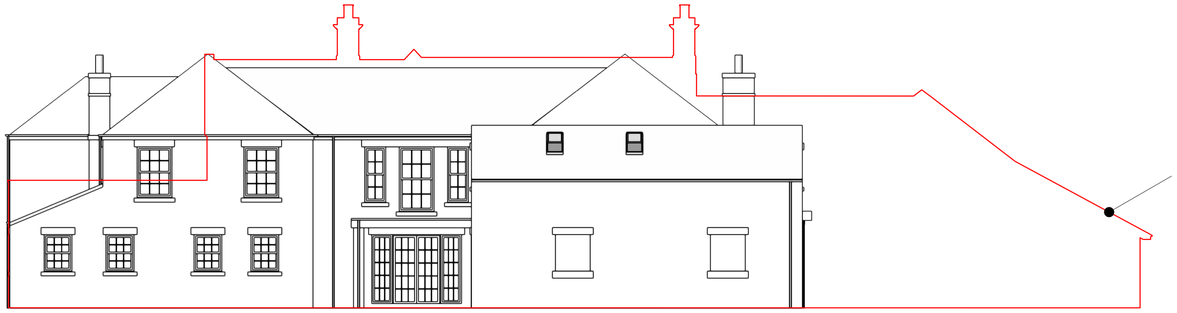

Redline indicates elevation of approved scheme
AVA/2020/0081

PROPOSED NORTH ELEVATION
(1:100)



Redline indicates elevation of approved scheme
AVA/2020/0081

PROPOSED WEST ELEVATION
(1:100)

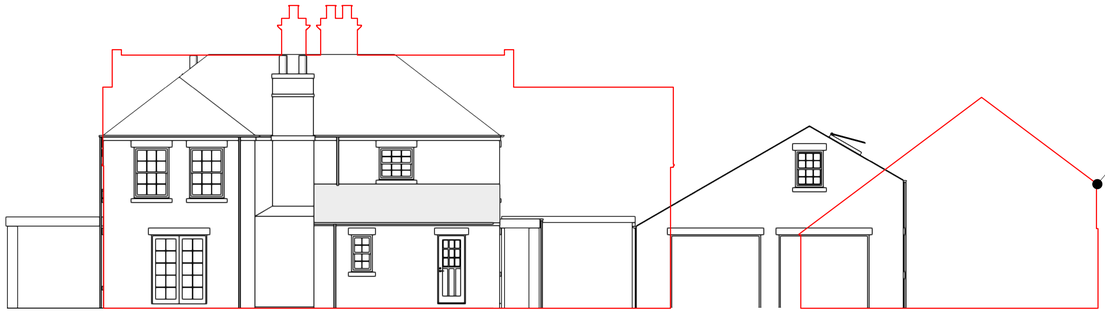

Redline indicates profile of approved scheme
AVA/2020/0081

PROPOSED SOUTH ELEVATION
(1:100)



Redline indicates elevation of approved scheme
AVA/2020/0081

PROPOSED EAST ELEVATION
(1:100)



ELEVATION KEY

1:200 - 0 2m 4m 6m 8m 10m 12m 14m 16m 18m 20m
1:100 - 0 1m 2m 3m 4m 5m 6m 7m 8m 9m 10m
1:50 - 0 1m 2m 3m 4m 5m
1:500 - 0 10m 20m 30m 40m 50m

CIOB THE CHARTERED INSTITUTE OF BUILDING
Chartered Building Consultancy

CIAT CHARTERED PRACTICE

General Notes

1. THIS IS AN A1 DRAWING, IF REPRODUCED IN ANY OTHER FORMAT THE SCALE SHOWN WILL BE INCORRECT
2. Do not scale off this drawing
3. Any ambiguities, omissions and errors on this drawing should be notified immediately to the Architect before the commencement of works on site
4. All dimensions are in millimetres unless otherwise stated
5. All dimensions, unless otherwise indicated, are to the face of unfinished block walls or to the stud face of stud partitions
6. All dimensions are to be checked on site. Any discrepancies are to be notified immediately to the Architect before the commencement of works on site
7. All levels are in meters unless otherwise stated
8. This drawing is to be read in conjunction with all other relevant drawings and specifications for this project

Rev	Description	Initial	Date

REYNOLDS ASSOCIATES

Midland Office
PO BOX 7988
ARNOLD
NOTTINGHAM
NG5 5ZU
T: 0844 2480045
F: 0871 750 1968

Cornwall Office
PO BOX 306
PAR
CORNWALL
PL25 9FW
T: 01726 813797
F: 0871 750 1968

reynolds-associates.co.uk
enquiries@reynolds-associates.co.uk

Job title

Proposed New Property
Lapwing Farm
Duffield

Mr & Mrs Grogan

Drawing title

Proposed Elevations
Indicting Existing Design

Scale at A1	1:100
Date	April 2022
Drawn by	SO
Checked by	KFR
Status	Planning

Job No.
11131

Drg. No. P112
Rev. No. -

RICS