35, TURNER AVENUE, LANGLEY MILL, HEANOR, DERBYSHIRE, NG16 4GE

Supplied by: www.ukmapcentre.com
Serial No: 240230
Centre Coordinates: 444339,347403
Production Date: 15/05/2022 09:49:29

North

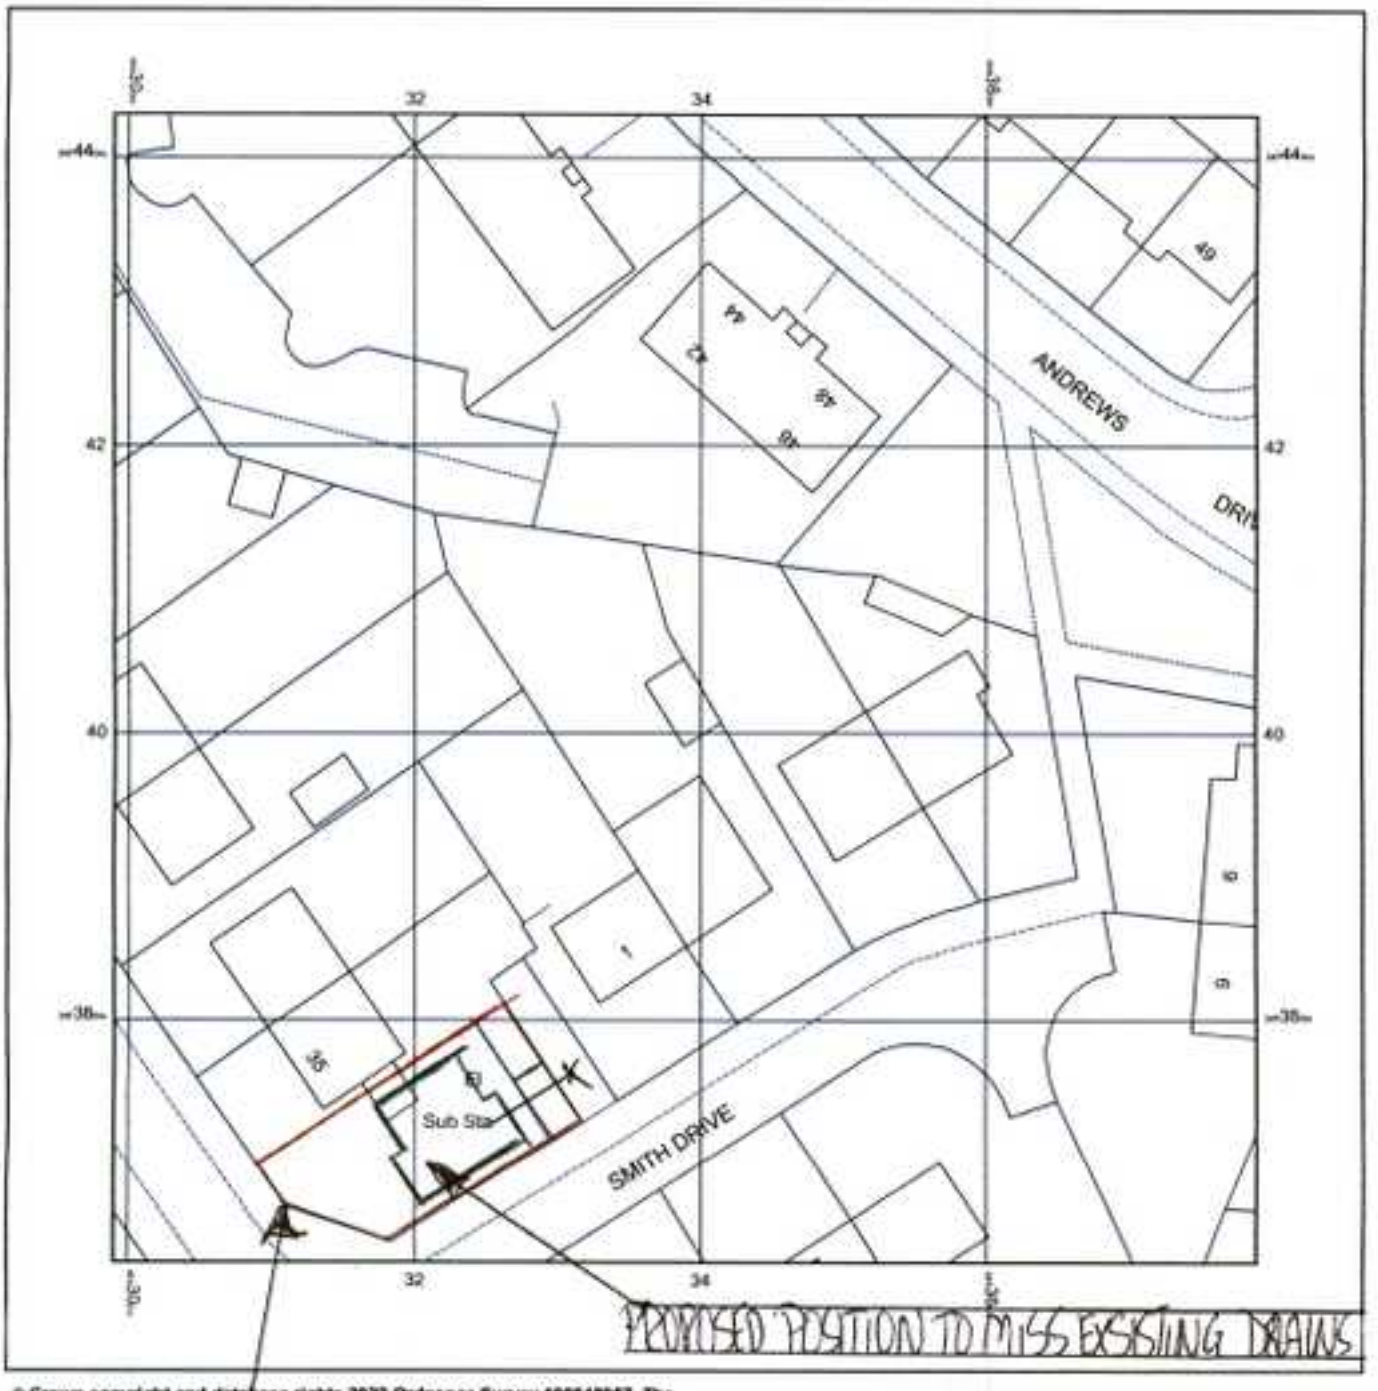

© Crown copyright and database rights 2022 Ordnance Survey 100048957. The representation of road, track or path is no evidence of a boundary or right of way. The representation of features as lines is no evidence of a property boundary.

0m 1cm = 5m 25m

Scale 1:500

PLOT BOUNDARY MARKED IN RED

AVA/2022/0677.

UK MAP CENTRE .com

Ordnance Survey