Red lines indicates proposed section lines of previous scheme as taken from drawing number NP/192/04A approved under AVA/2008/0906.

0 2m 4m 6m 8m 10m 12m 14m 16m 18m 20m
SCALE BAR 1:200

bi Design Architecture
HEAD OFFICE
78 HIGH STREET, REPTON, DERBYSHIRE, DE65 6GF
T: 01283 704382
WEST MIDLANDS OFFICE
42A HIGH STREET, SUTTON COLDFIELD, B72 1UJ
T: 0121 354 5255
ENQUIRIES@BIDESIGN-ARCHITECTURE.CO.UK WWW.BIDESIGN-ARCHITECTURE.CO.UK

PLEASE NOTE: USE FIGURED DIMENSIONS ONLY. CONTRACTOR TO CHECK ALL LEVELS AND DIMENSIONS ON SITE PRIOR TO WORKS COMMENCING AND REPORT ANY DISCREPANCIES TO BI DESIGN ARCHITECTURE

Project: Proposed residential development at
Address: 21 & 23 The Common, Crich

Client: Murfin

Drawing: Site Sections

Job Ref: 1589M Date: 24/01/22
Drawn By: MAC Check By: DPB
Scale: 1:200 Drawing No: 06B
Paper Size: A2

MEMBER OF THE CHARTERED INSTITUTE OF BUILDING
MEMBER OF THE CHARTERED INSTITUTE OF ARCHITECTURAL TECHNOLOGISTS
AFFILIATE MEMBER OF THE ROYAL INSTITUTE OF BRITISH ARCHITECTS

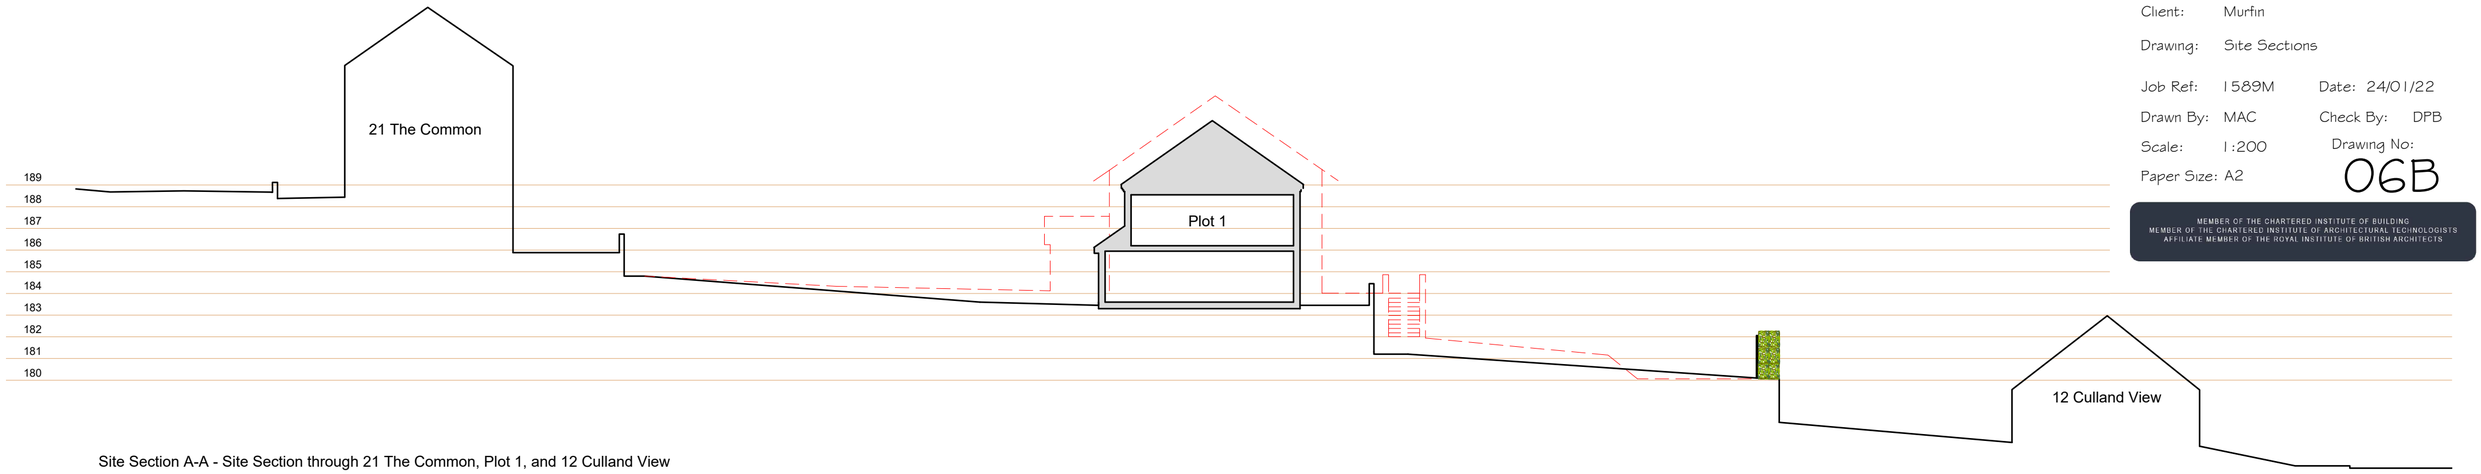

Site Section A-A - Site Section through 21 The Common, Plot 1, and 12 Culland View

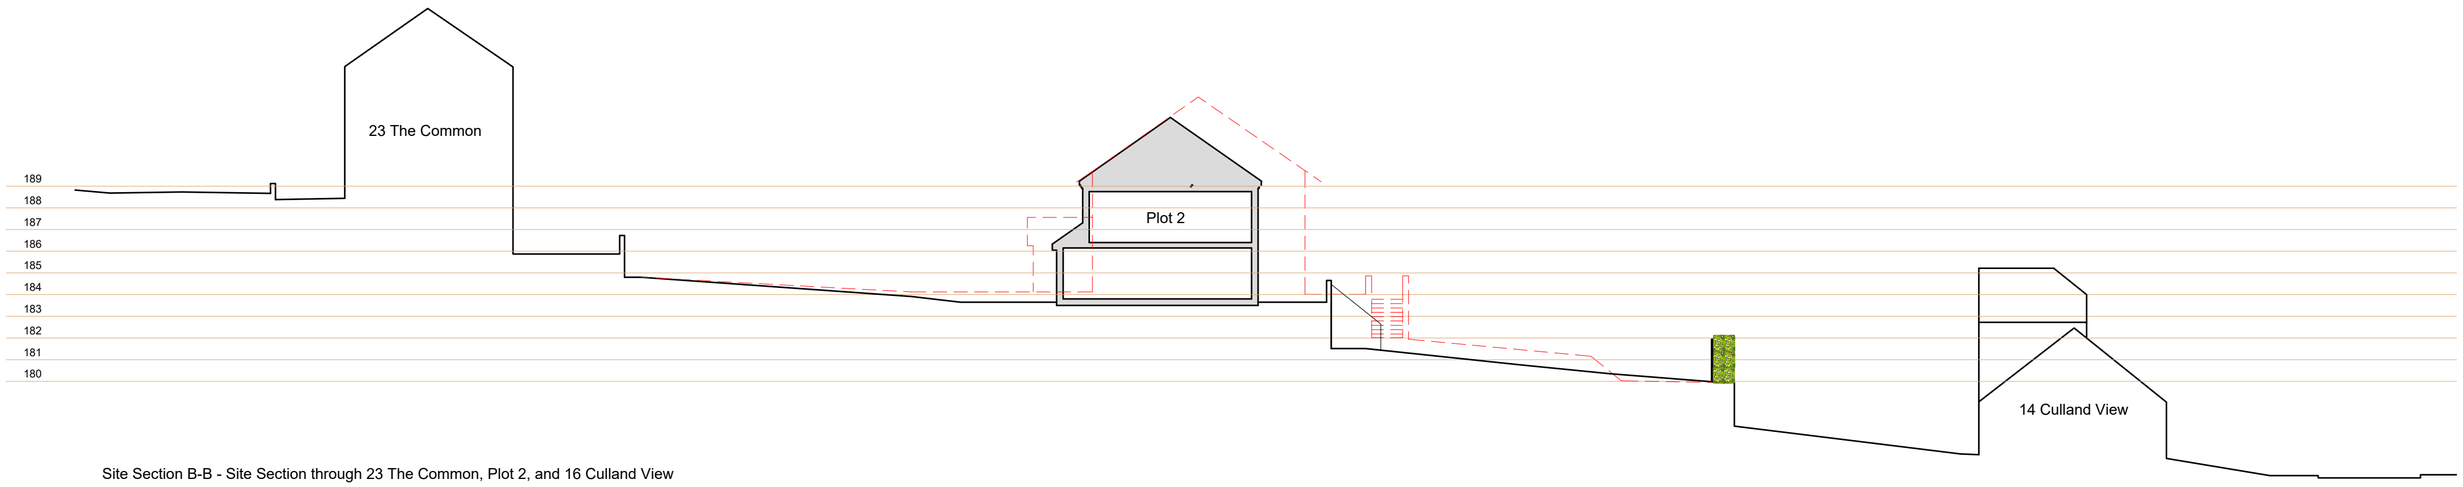

Site Section B-B - Site Section through 23 The Common, Plot 2, and 16 Culland View

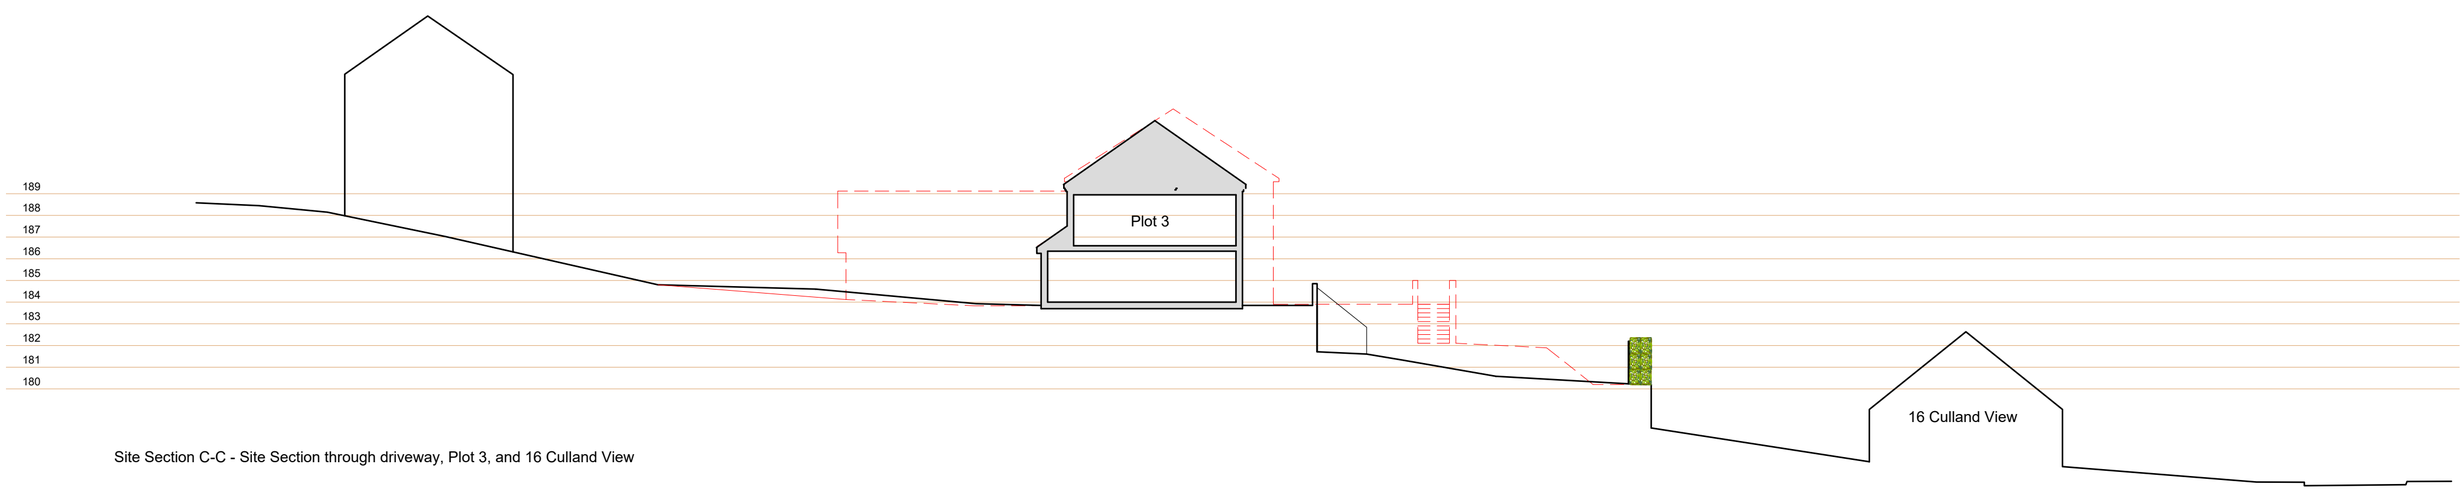

Site Section C-C - Site Section through driveway, Plot 3, and 16 Culland View