AVA/2022/0345

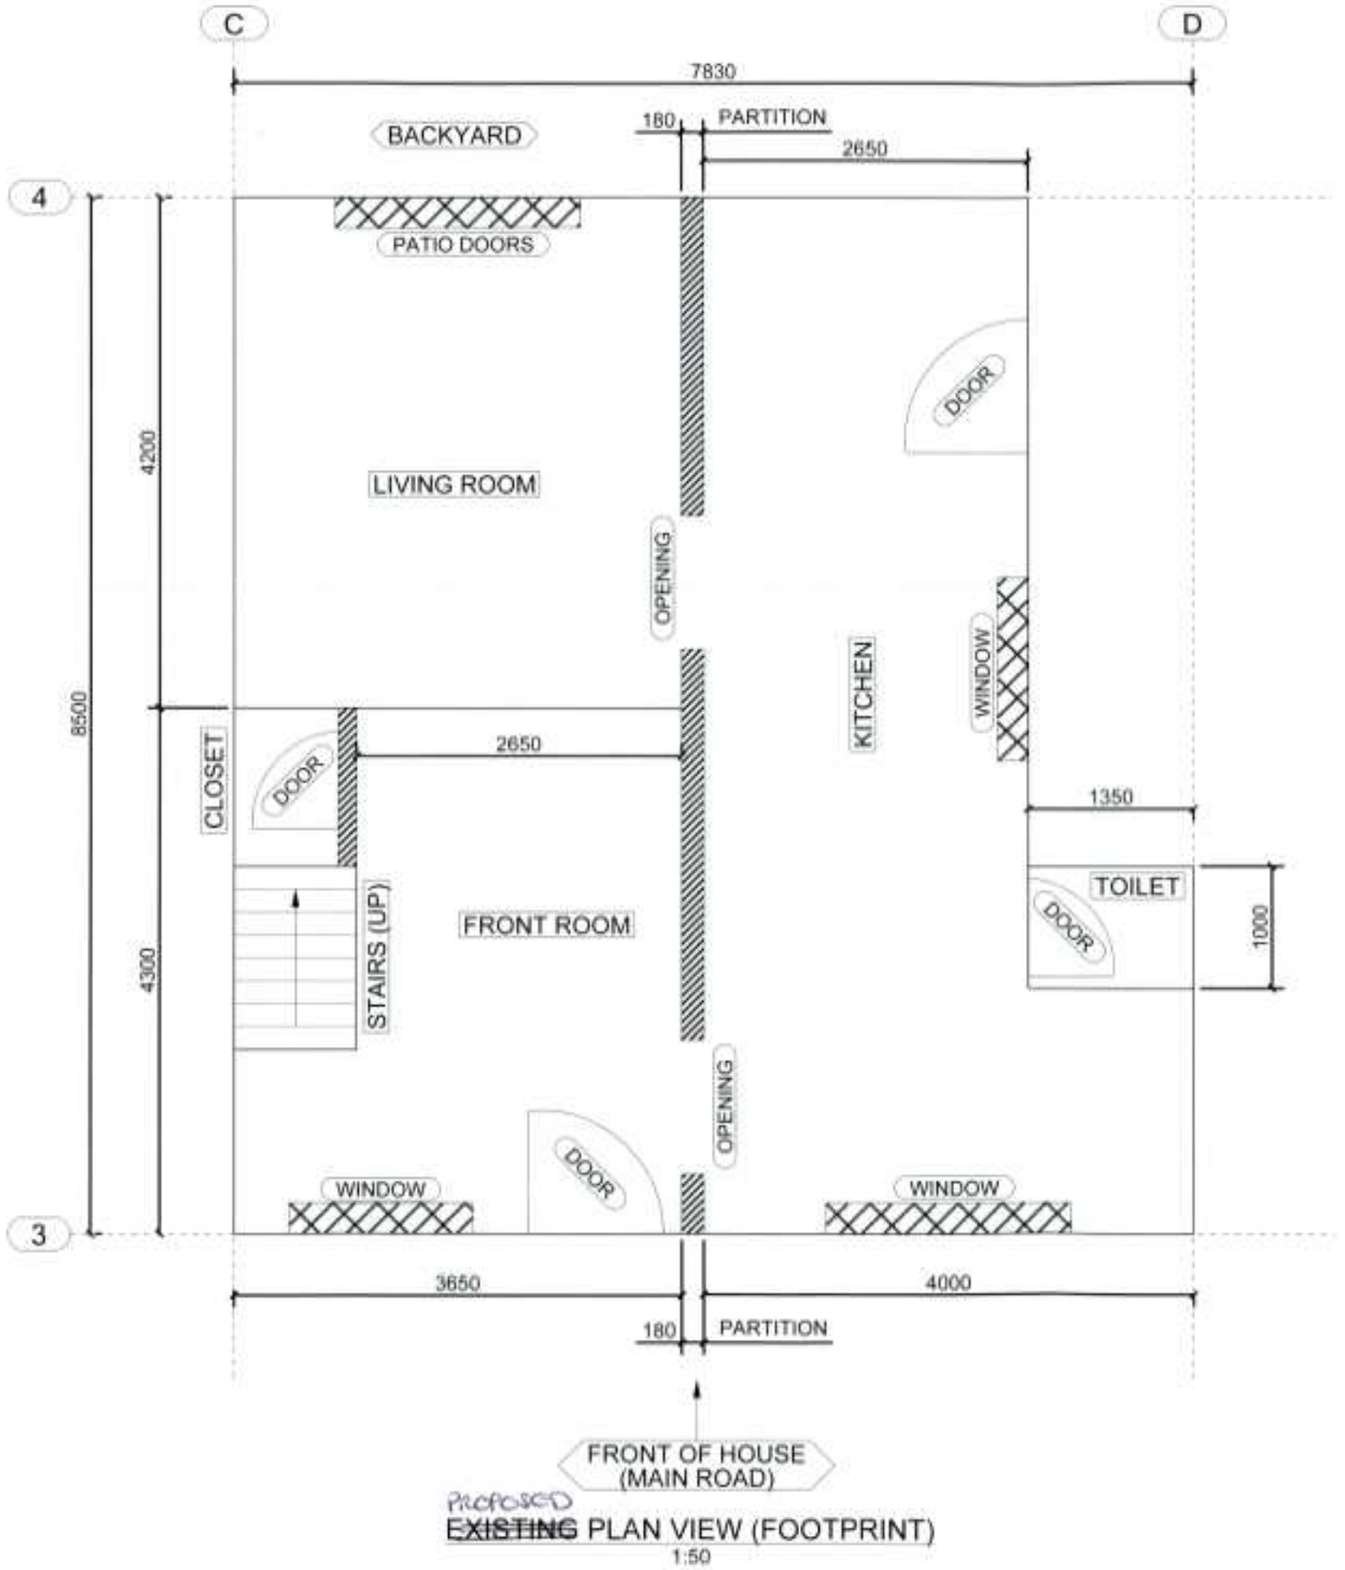

PROPOSED
~~EXISTING~~ PLAN VIEW (FOOTPRINT)
1:50

REV MARK	DESCRIPTION	By	Date	By	Date
		CREATED		CHECKED	

CLIENT: MRS DOROTHY PARKER			
ADDRESS: 209 & 211 NOTTINGHAM RD, SOMERCOTES			
DRAWING TITLE:	211 NOTTINGHAM RD EXISTING FLOOR PLAN		
CONTRACT:	~~209 &~~ 211 NOTTINGHAM ROAD		
DRAWN BY:	MAB	ISSUE DATE	
CONTRACT NO:	MAB_001	SCALE	1:50
DRAWING NO:	FP002	REVISION No.	

Tekla Structures

Tekla structures