AVA/2022/0345

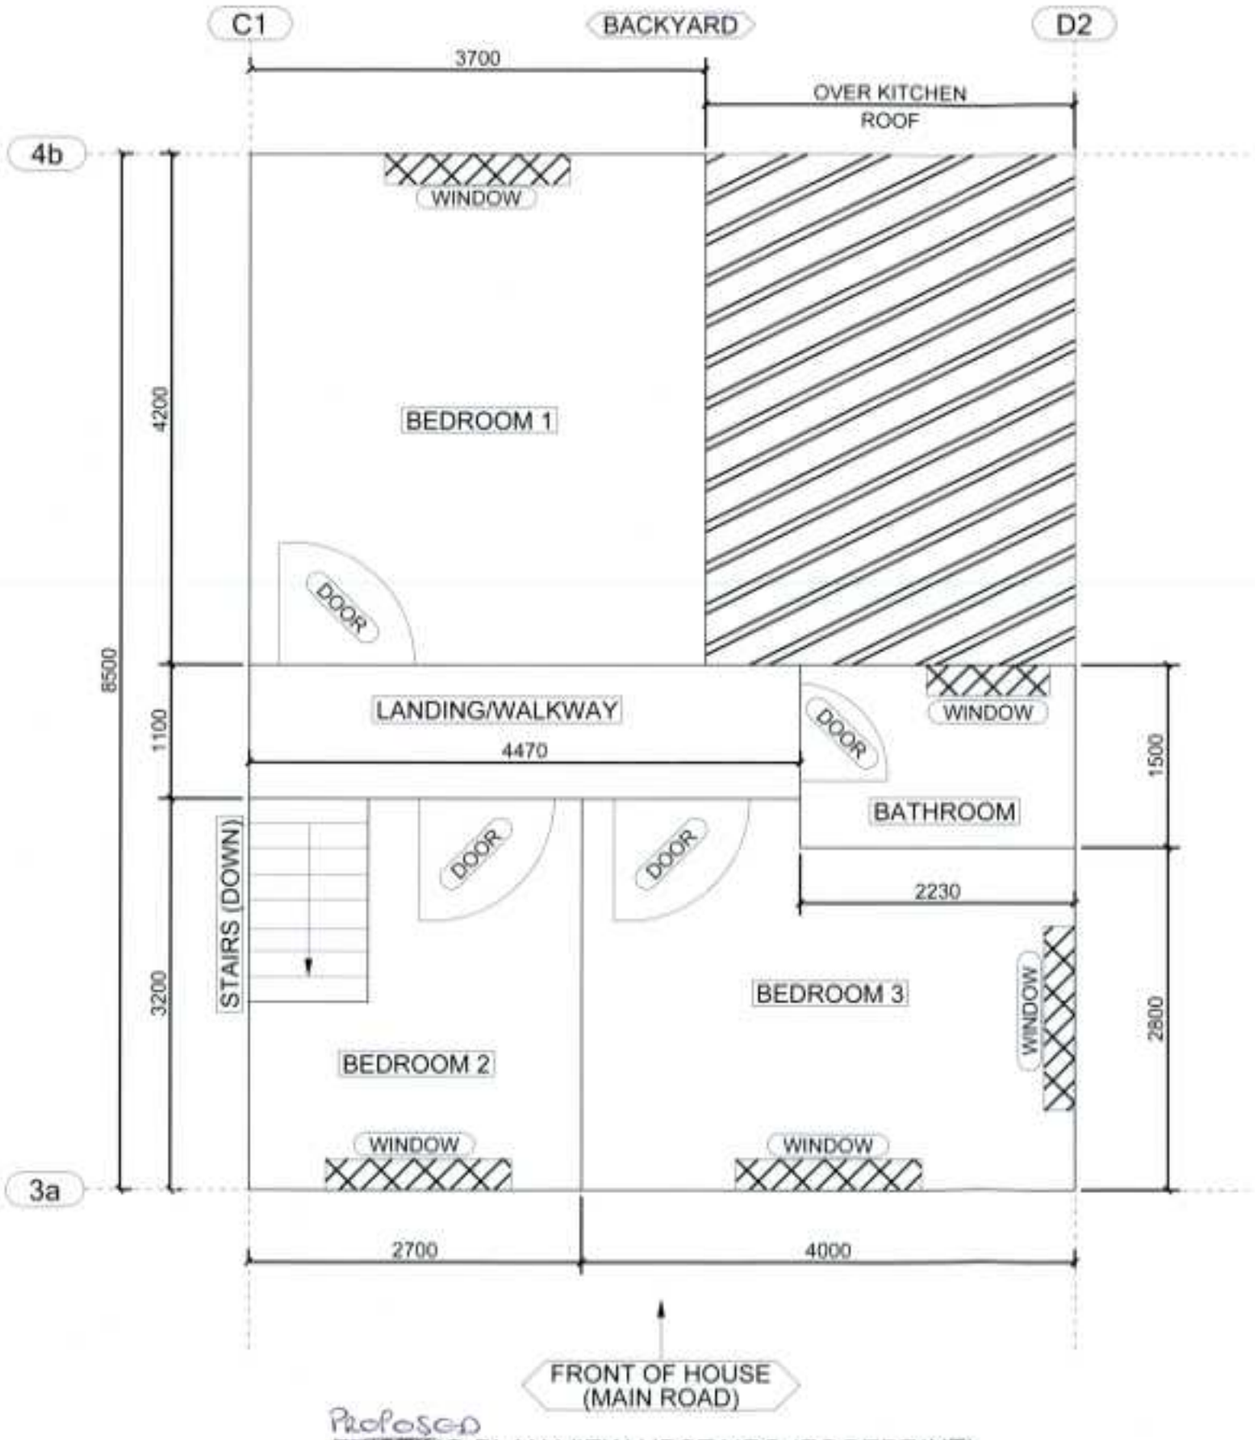

Proposed
~~EXISTING~~ PLAN VIEW UPSTAIRS (FOOTPRINT)
1:50

REV MARK	DESCRIPTION	By	Date CREATED	By	Date CHECKED

CLIENT: MRS DOROTHY PARKER		Tekla Structures	
ADDRESS: 209 & 211 NOTTINGHAM RD, SOMERCOTES			
DRAWING TITLE:	211 NOTT'HAM RD EXT UPSTAIRS FLOOR PLAN		
CONTRACT:	~~209 &~~ 211 NOTTINGHAM ROAD		
DRAWN BY:	MAB	ISSUE DATE	
CONTRACT NO:	MAB_001	SCALE	1:50
DRAWING NO:	FP004	REVISION No.	

Tekla structures