

PROPOSED FRONT ELEVATION.

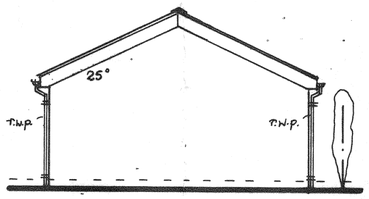

REAR ELEVATION.

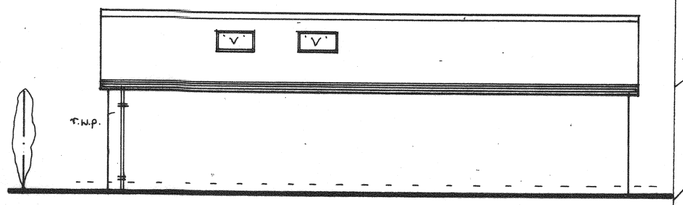

SIDE ELEVATION.

SIDE ELEVATION.

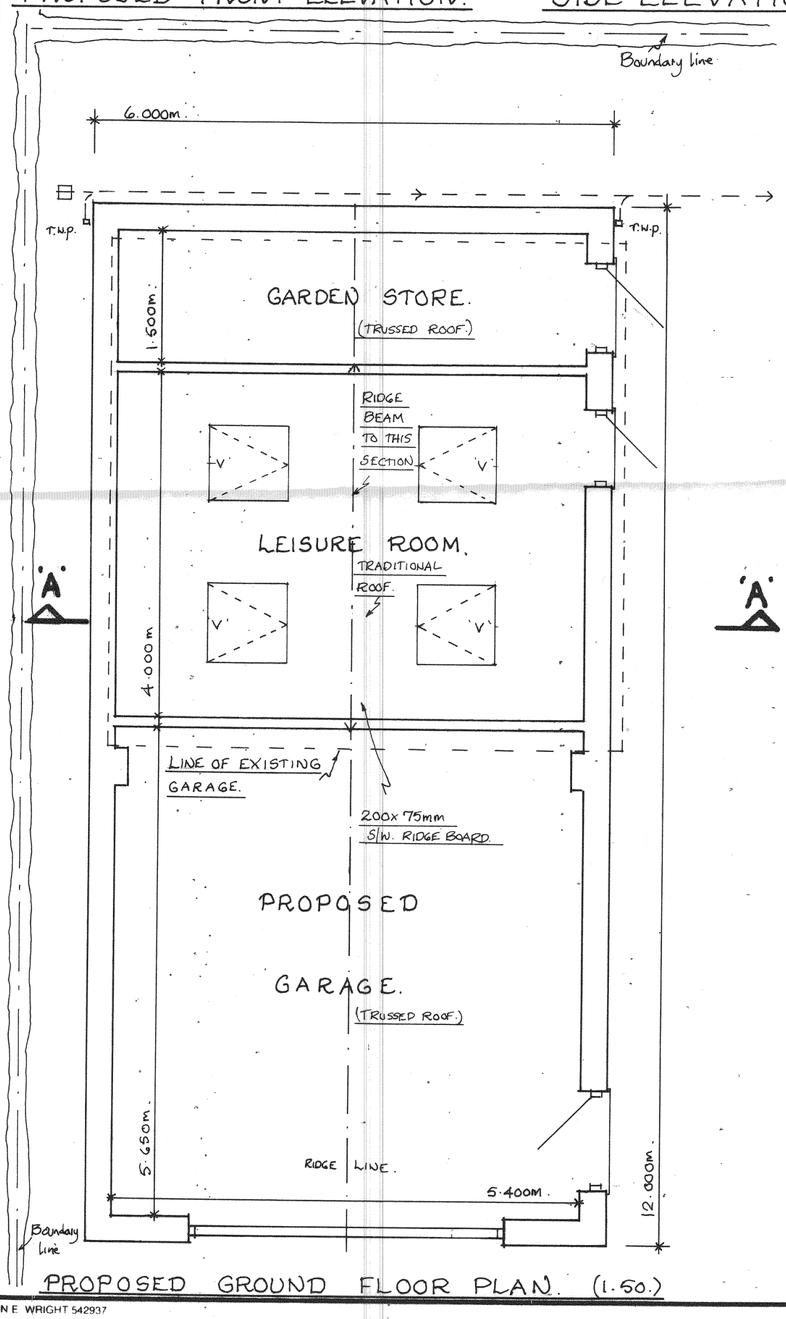

PROPOSED GROUND FLOOR PLAN. (1.50.)

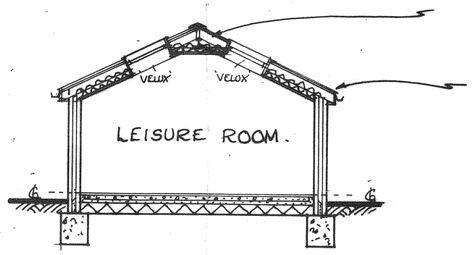

SECTION A:A.

ROOF SPEC :-

Ridge beam to be 203 x 102 UB 23 grade S275.

Rafters to be 150 x 47mm softwood at 450mm centres. C16 grade timber.

Rafters to be doubled-up at sides of 'VELUX' roof lights.

Notes:
All dimensions must be checked on site and not scaled from this drawing.

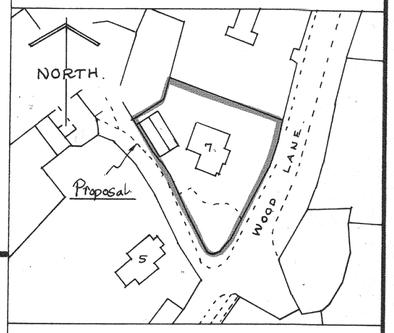

LOCATION PLAN. (SCALE-1:1250)

A	06-04-17.	ROOF DETAILS/SECTION. ETC.
	Date	Revisions

© copyright

Client
MR. & MRS. J. RICHARDSON.

Job Title
PROPOSED DETACHED GARAGE WITH LEISURE/STORE ROOMS AT No. 7 WOOD LANE, HORSLEY WOODHOUSE, DERBY'S.

Drawing Title
'AS BUILT' LAYOUTS.
PROPOSED - LAYOUTS.
(APPLICATION FOR A LAWFUL DEVELOPMENT CERT.)

Scale 1:100 & 1:1250 & 1:50.

Date OCT. - 2022. | Drawn by ETO

DICKINSON BUILDING DESIGN LTD.
BUILDING DESIGN CONSULTANTS
Domestic/Industrial/Commercial
Local Authority Approvals
Building Plans
Grants etc.
☎ 01332 831429
Rectory Lane
Breadsall
Derby
DE21 5LL

Drg. No.	Rev.
~~17/05/2016/01.A~~ 03/10/2022/01	A 06-04-17. ETO

JOHN E. WRIGHT 542937

420 x 594mm A2.