

Rear Elevation as Constructed

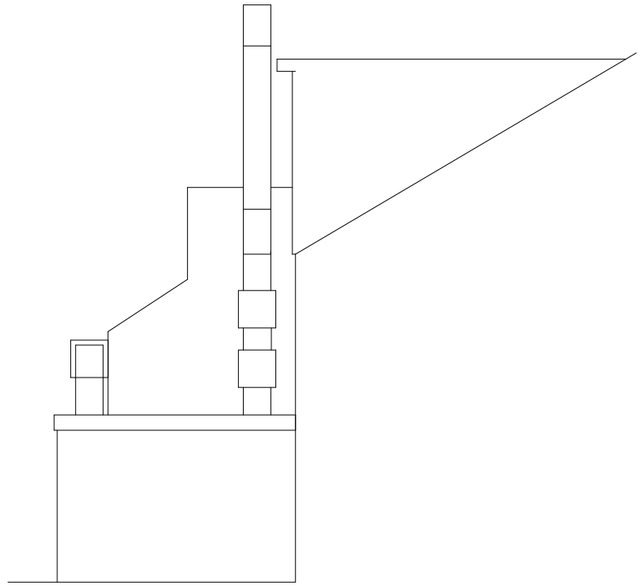

Side Elevation as Constructed

15 Loscoe Road Heanor

Scale 1:100@A3

Drg NO 1193/01