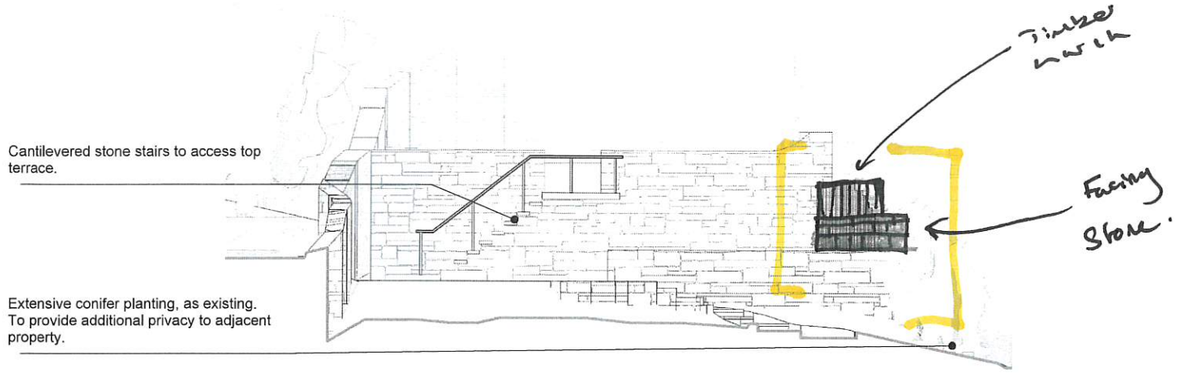

3 | Section 10 | 1 : 100

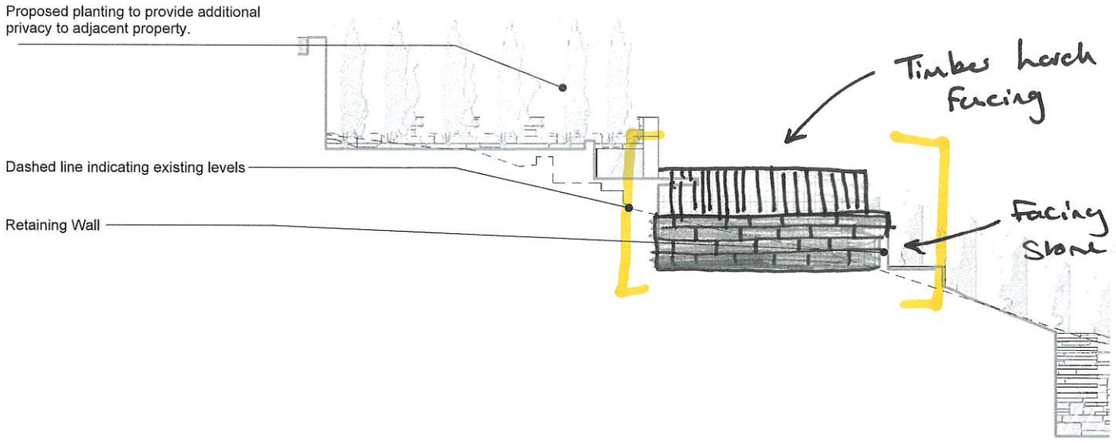

2 | Section 9 | 1 : 100

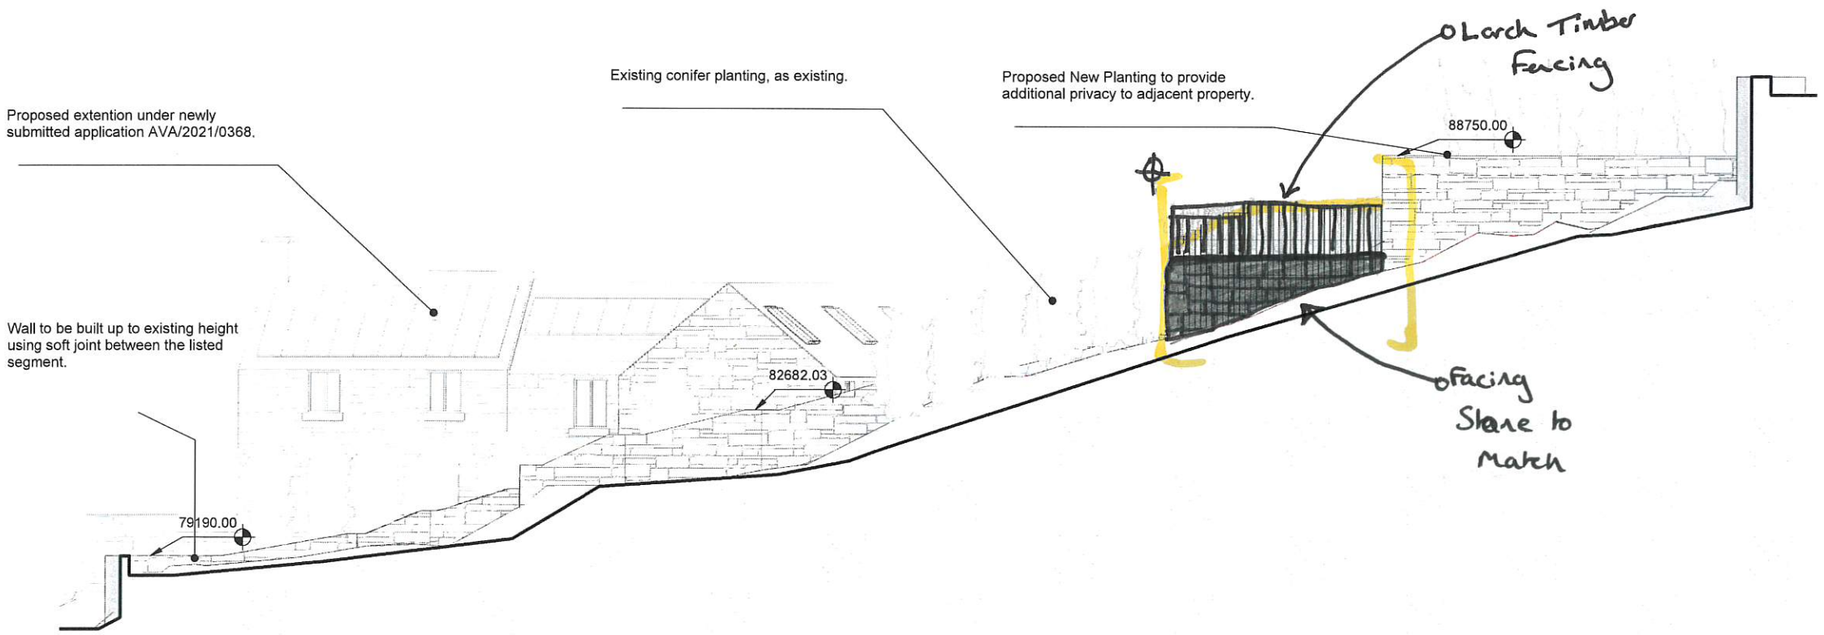

1 | South Elevation | 1 : 100

rev	date	issued	description
C	2022.09.05		Removal of Shed
B	2022.08.23	OL	Pre Submission Amendments
A	2022.08.05	IT	Internal and external alterations.

Newark Studio
t: 01635 605100

Derby Studio
t: 01332 557557

Manchester Studio
t: 0161 8261042

GUY TAYLOR ASSOCIATES
NEWARK / MANCHESTER / DERBY

A2
Original Sheet Size

STATUS
Planning

- All rights described in chapter IV of the copyright, designs and patents act 1988 have been generally asserted
- Where any drawing is to be read in conjunction with another, including specialists, the two drawings shall be cross-checked and any descrepancies reported to the architect before the work is put in hand
- All dimensions are in millimeters, all levels are in metres, unless shown otherwise
- Any discrepancies in dimensions or details on or between these drawings/specifications should be drawn to the attention of the Guy Taylor Associates and or the engineer in writing for clarification
- Drawing prepared solely for the use of client, as detailed in text box, and is not to be copied, lent or used by any third party without written permission

PROJECT
White Cottage
Duffield Bank
Duffield
DE56 4BG

CLIENT
~~Mr. Mathew Bailey~~ WIP

DRAWING TITLE
~~**Proposed Landscaping Sections**~~

SCALE	DATE	DRAWN	CHK
~~1 : 100~~	~~08/17/22~~	~~OL~~	~~RS~~

DRAWING NUMBER
~~**842.1311.2 (08)009**~~

REVISION
~~C~~

© COPYRIGHT