REVISION		DATE
A	Added Skylights	11/07/22
B	Moved Outbuilding	01/11/22
C	Post App Amendments	01/03/23

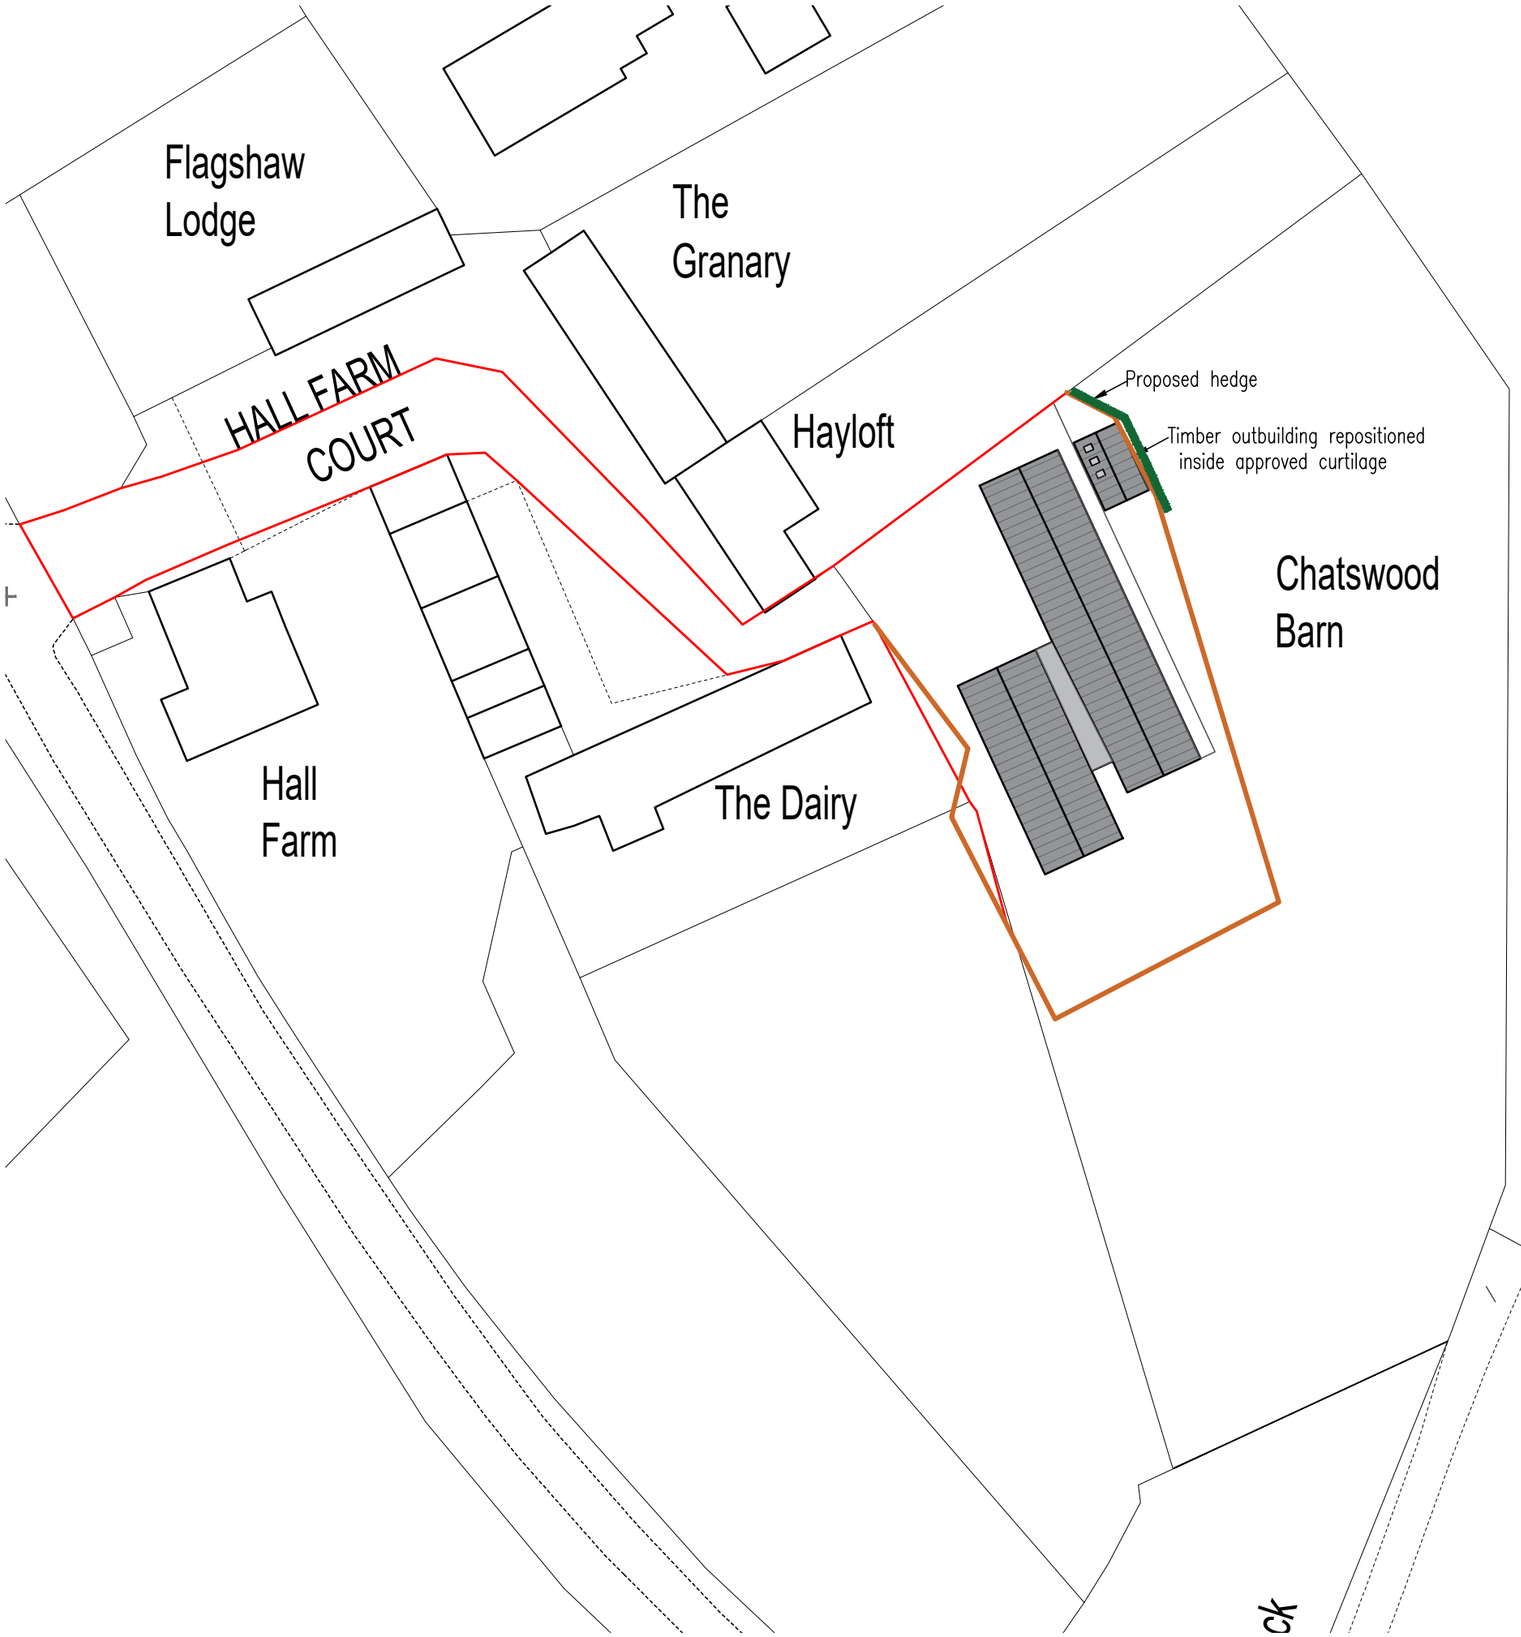

KEY

Approved curtilage

PlanningDesign

Second Floor, Suite 3
Woburn House
Vernon Gate
Derby
DE1 1UL

Tel: 01332 347 371
E-mail: info@planningdesign.co.uk
www.planningdesign.co.uk

PROJECT DESCRIPTION:
Application for retention of timber outbuilding

DRAWING TITLE:
Block Plan as built

DRAWN BY:	CHECKED BY:
JB	-

CLIENT
Richard Silverwood

DRAWING NUMBER:	REVISION:
002	C

SCALE:	DATE:
1:500 @ A3	June 2022

STATUS
AS BUILT

DRAWING REF:
3900- 002

© COPYRIGHT EXISTS ON THE DESIGNS AND INFORMATION SHOWN ON THIS DRAWING : The Contractor must verify all dimensions on site before making shop drawings or commencing work of any kind. No dimensions to be scaled from this drawing. Architect to be notified of any discrepancies in dimensions immediately