




EXISTING ELEVATION A

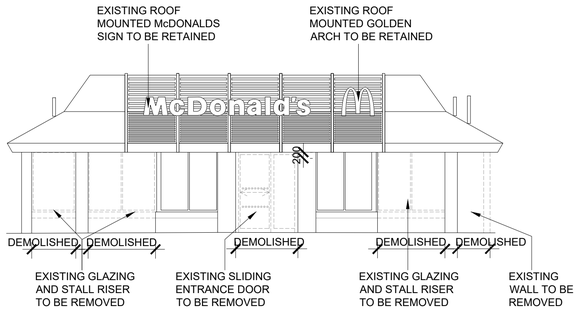


EXISTING ELEVATION B

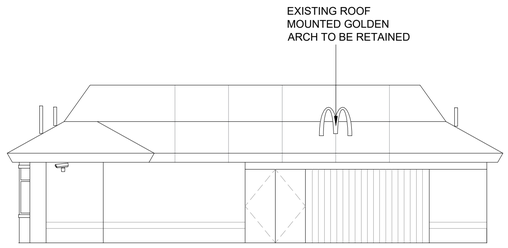


EXISTING ELEVATION C

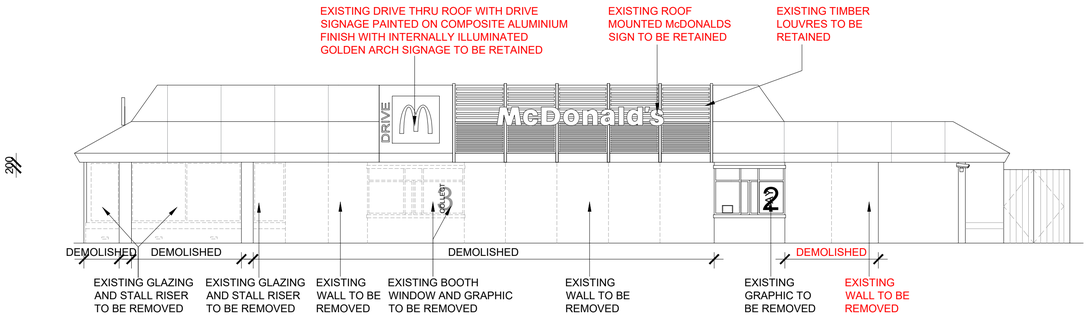

EXISTING ELEVATION D

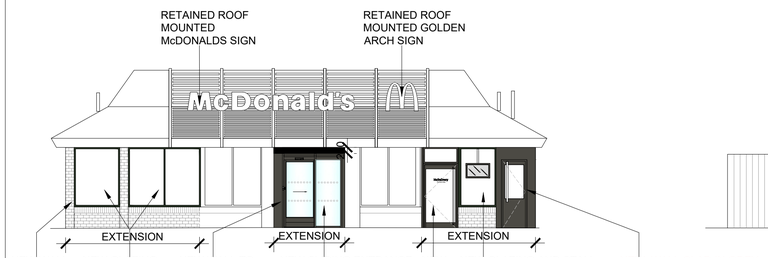


PROPOSED ELEVATION A

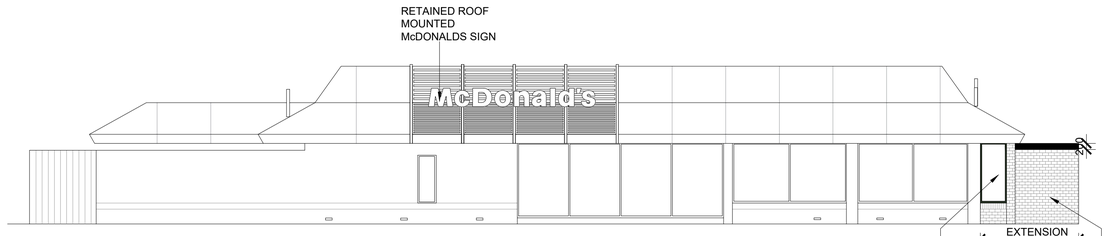

PROPOSED ELEVATION B

PROPOSED ELEVATION C

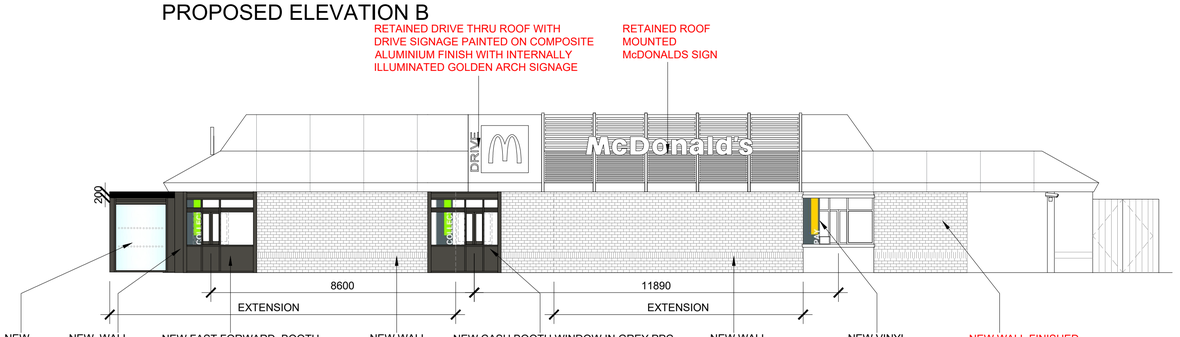

PROPOSED ELEVATION D

0 1 2 3 4 5m

Scale 1:100

EXISTING & PROPOSED SITE ELEVATIONS 1:100

BUILDING FINISHES			
DESCRIPTION	EXISTING		PROPOSED
WALLS	BRICK, GREY CLADDING	AS EXISTING	
ROOF	COMPOSITE LOUVRE OVERCLAD IN ALUMINIUM REYNOBOND 4mm DG5000 TEINTE BOIS D.8103.MR REVERSE REYNOBOND CLAY BROWN A8103S FINISH DG5000	DRIVE THRU ROOF WITH DRIVE SIGNAGE PAINTED ON COMPOSITE ALUMINIUM FINISH WITH INTERNALLY ILLUMINATED GOLDEN ARCH SIGNAGE	FULL ROOF OVERCLAD IN COMPOSITE ALUMINIUM 4mm REF: INTERPON MK 120E DARK GREEN — AS EXISTING
WINDOW FRAMES	KHAKI GREEN PAINTED		AS EXISTING
SOFFIT & FASCIAS	INTERNAL ILLUMINATED		AS EXISTING
DOORS	GLAZING, KHAKI GREEN PAINTED		GREY RAL 7022
BOOTH WINDOWS (inc surrounds)	ALUMINIUM KHAKI & TIMBER EFFECT CLADDING		OVER CLAD IN GREY RAL.7022 ALU. AND FRAMES DECORATED GREY RAL.7022 WITH APPLIED BOOTH GRAPHICS

NOTES

- All dimensions and levels are to be checked on site.
- Any discrepancies are to be reported to the architect before any work commences.
- This drawing shall not be scaled to ascertain any dimensions. Work to figured dims only.
- This drawing shall not be reproduced without express written permission from AEW.
- Title overlay drawings and ownership boundaries are produced using all reasonable endeavours. AEW cannot be responsible for the accuracy or scale discrepancy of base plans supplied to them.
- All works are to be undertaken in accordance with Building Regulations and the latest British Standards.
- All proprietary materials and products are to be used strictly in accordance with the manufacturers recommendations.


CDM 2015

Client notified of duties: **At Design Workshops**

Principal Designer: **CSS**

Unless noted below, all known hazards have been highlighted on the drawing:

Notes:
All drawings to be read in conjunction with all other drawings as noted on issue sheet.

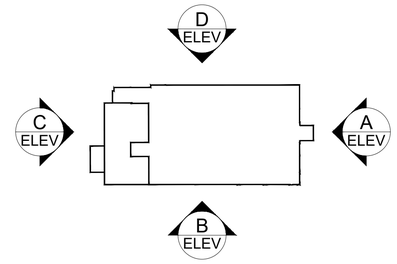

KEY PLAN - NTS

REV	Date	Drawn by: -	Checked by: -
A	26/04/23	AB	DP

UPDATED FOLLOWING STAGE 1 MEETING 11/04/2023
- EXISTING ROOF SIGNAGE RETAINED TO ELEVATION D
- EXISTING WALL REMOVED AND NEW WALL SHOWN TO ELEVATION D
- NEW DOOR SHOWN TO ELEVATION A
- KEY PLAN UPDATED TO SUIT EXTENSION TO OFFICE
- ISSUED FOR PLANNING

UPDATES INDICATED IN RED TEXT

-	24/03/23	PC	MW

INITIAL ISSUE

Status: **S2** Purpose of Issue: **For Approval**

drawing stage: **PLANNING**

client: **McDonald's Restaurants Ltd**

project: **ALFRETON NOTTINGHAM ROAD DERBY DE55 7FA** store: **1117**

drawing title: **EXISTING & PROPOSED SITE ELEVATIONS**

date: **24/03/2023** drawn: **PC**

scale@A1: **1:100** checked: **MW**

PLANNING

Rev **A**

Job No **13189_AEW_1117_0005**

aew architects
0161 214 4370
www.aewarchitects.com