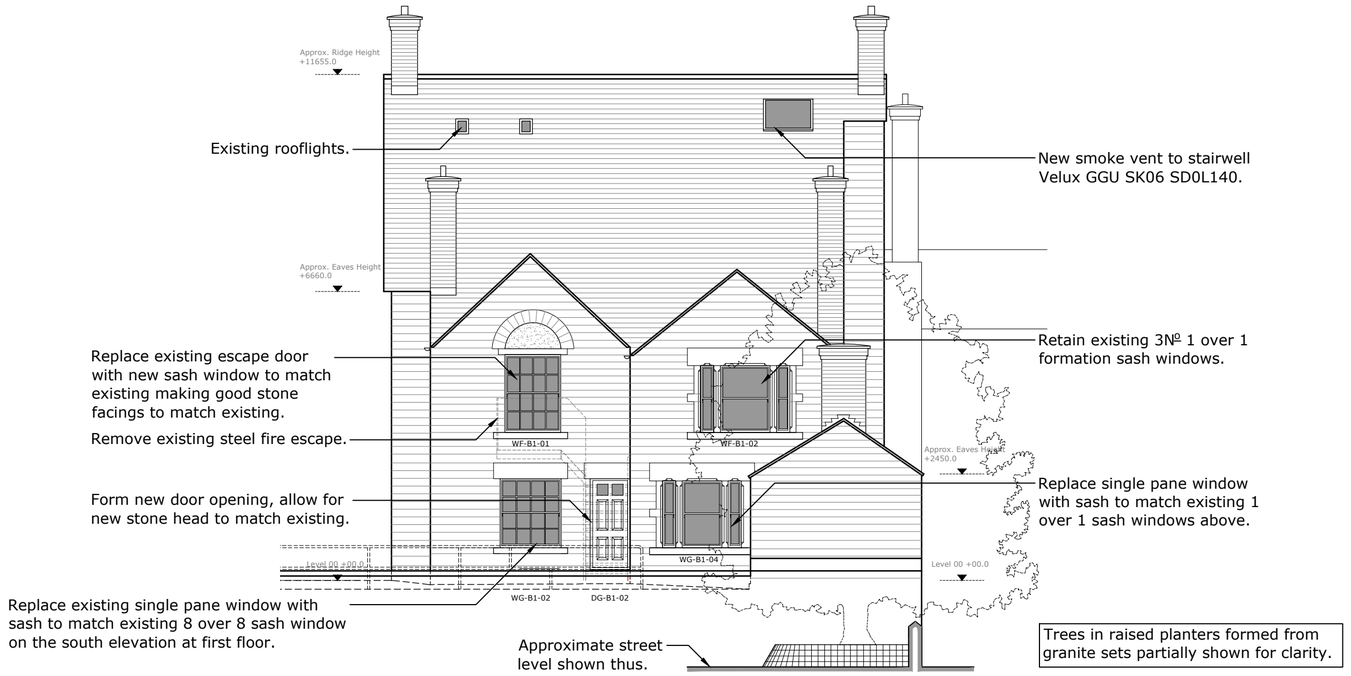

Elevation A (East, Bridge Street)

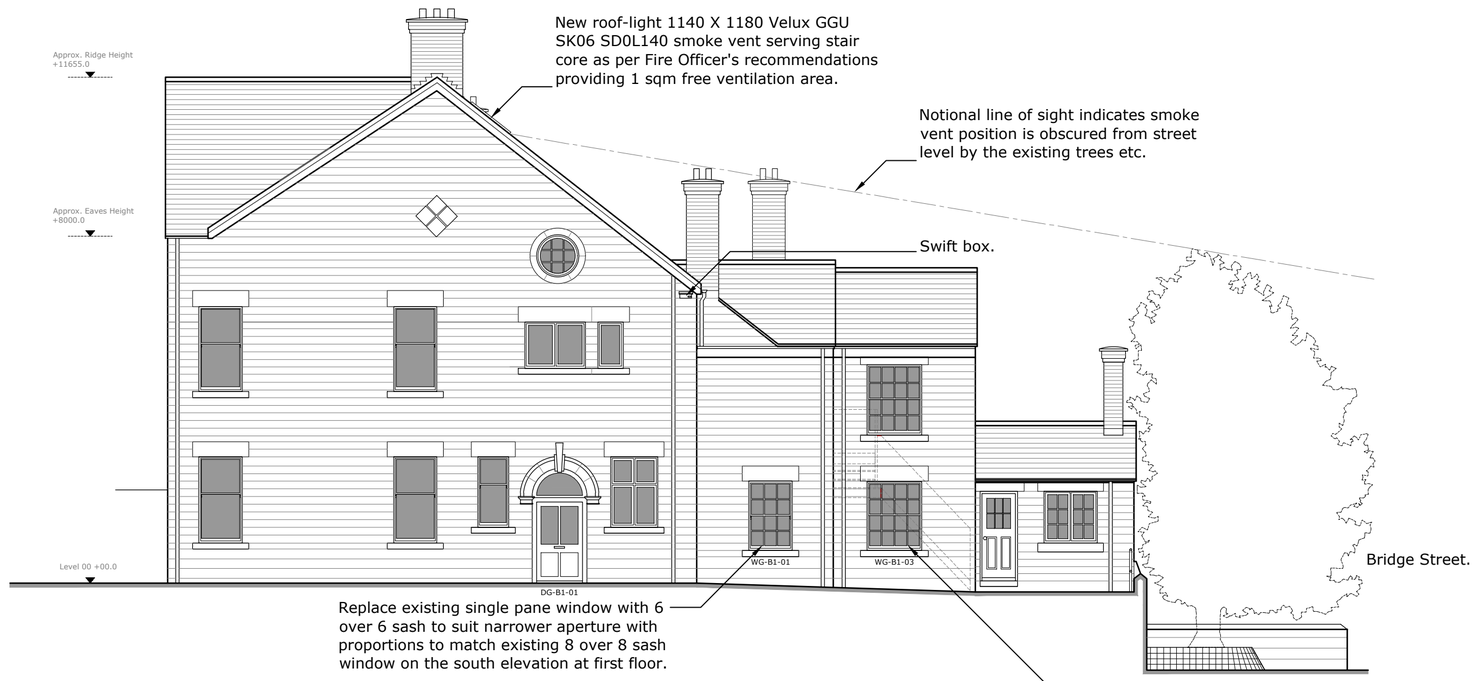

Elevation B (South, Main Entrance)

1:100 Paper Scale Check (mm)

0 2000 4000 6000

Notes:

1. Do not under any circumstances scale from this drawing for the purpose of tender or construction, use figured dimensions only.
2. All dimensions are in mm unless otherwise stated and are, unless otherwise stated, to the face of unfinished plasterboard or similar (ie. does not include final skim and/or other decoration).
3. This drawing is not to be used for the purposes of Tender or Construction except where specifically identified for such use in the Drawing Status section of this drawing.
4. All existing dimensions are to be verified on site by the contractor before any work commences.
5. All existing wall construction and other hidden elements are assumed and are to be verified on site by the contractor before any work commences.
6. Any ambiguities, omissions or errors on this drawing are to be notified immediately to Indigo Architecture before work commences on site.
7. This drawing is to be read in conjunction with all other relevant Architectural, Structural, Civils, M&E Services and any other specialist supplier drawings and specifications.
8. All existing services are to be checked and confirmed on site by the contractor before any work commences.
9. The contractor is not to commence any works on site until seeking and obtaining confirmation that all relevant pre-commencement conditions have been discharged appropriately.
10. This drawing is the property of Indigo Architecture Ltd. and is issued strictly for use on the project for which it is provided and is issued on the condition that it is not copied, reproduced, retained or disclosed to any unauthorised person, either wholly or in part, without the express written consent of Indigo Architecture Ltd.

Key:

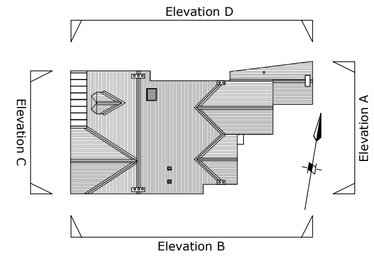

Rev:	Description:	By:	Date:
D	Discharge of Conditions	ASM	27.08.2025

Indigo Architecture
Darley Abbey Stables, Abbey Yard, Darley Abbey, DE22 1DS
t: 0133 254 1691
e: hello@indigo-architecture.co.uk

Project Title:
The Hollies
105 Bridge St
Belper
DE56 1BA

Drawing Title:
Building 1 - GA Elevations A and B

Drawing No: 0284-3-21-00

Revision: D

Scale: 1:100

Designed by: ASM

Stage: 3

Sheet Size: A2

Checked by: CB

Date: 17.12.21

Drawing Status: AS BUILT