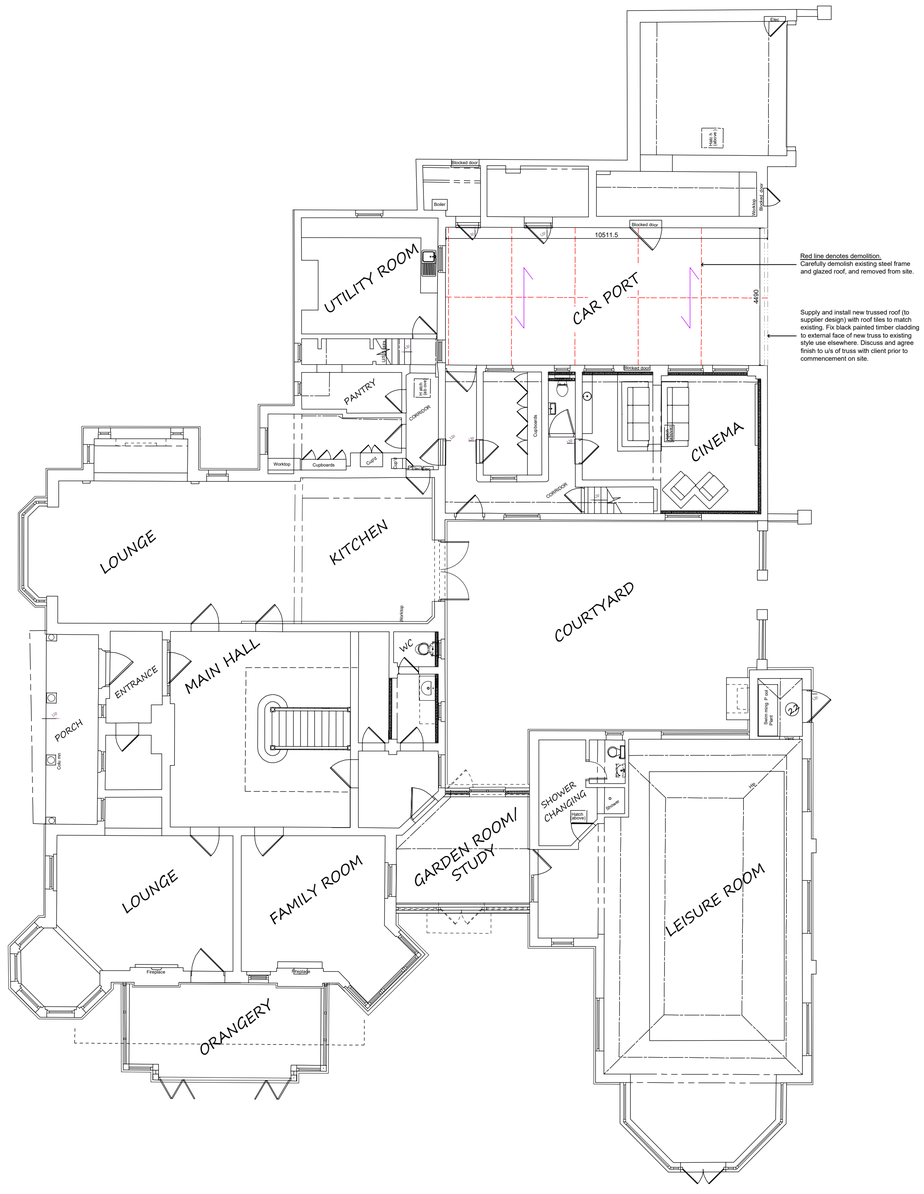

Bin
Block paving
Blocked door
Boiler
10511.5
UTILITY ROOM
CAR PORT
Red line denotes demolition.
Carefully demolish existing steel frame and glazed roof, and removed from site.
Supply and install new trussed roof (to supplier design) with roof tiles to match existing. Fix black painted timber cladding to external face of new truss to existing style use elsewhere. Discuss and agree finish to u/s of truss with client prior to commencement on site.
4490
PANTRY
Cupboards
Worktop
Cupboards
Cooker
Sink
Cupboards
Cupboards
Fridge
CINEMA
Cupboards
LOUNGE
KITCHEN
COURTYARD
Worktop
ENTRANCE
MAIN HALL
WC
PORCH
Cupboard
Shelving
Shelving
Shelving