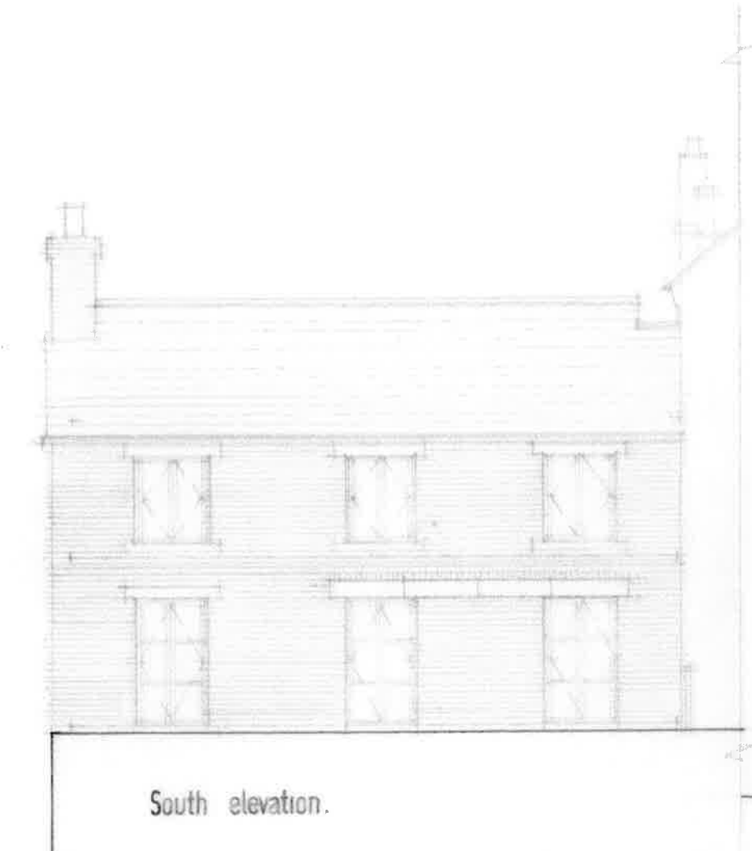

South elevation.

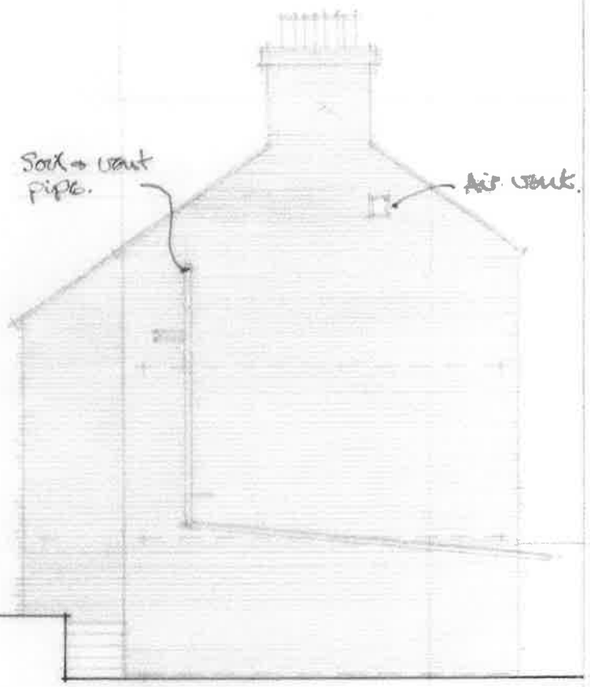

West elevation.

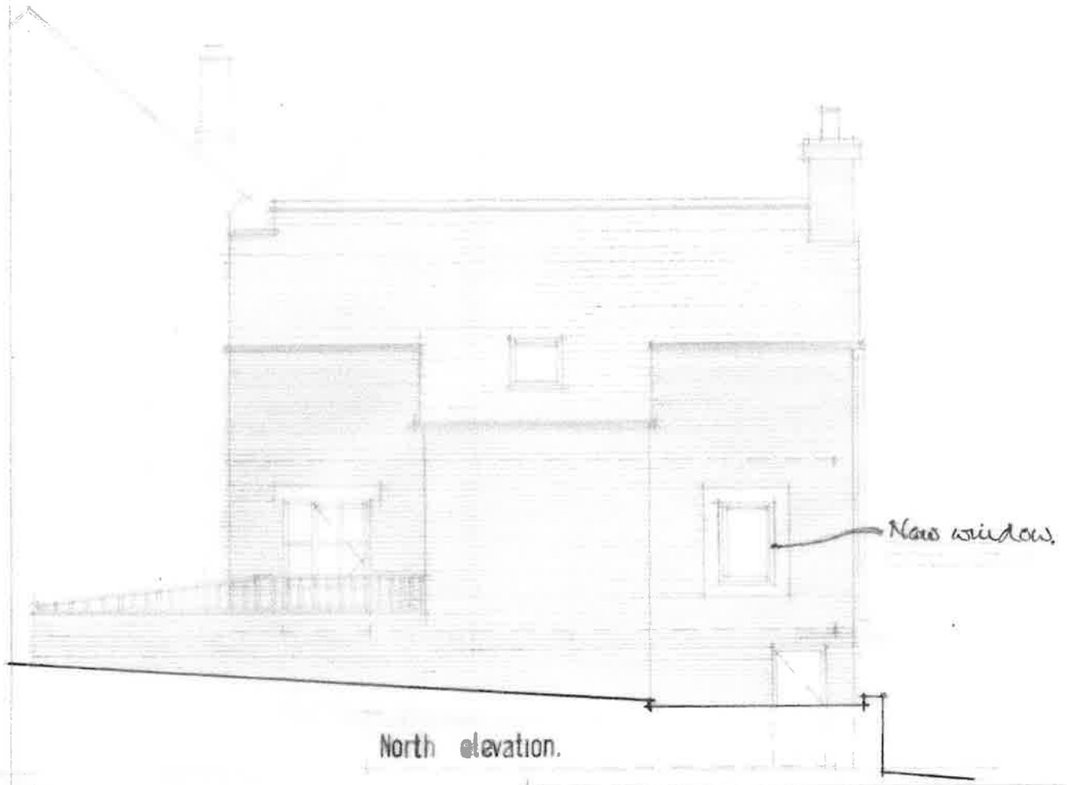

North elevation.

Ground floor plan.

First floor plan.

North

Scale: 1:50.

A 3.10.25 Windows + doors at 1:50 added. + detail refs 740 doors

project Proposed alterations, The Old School House, Green Lane, Belper.

client C. Jones.

As Constructed.

Swinfield Design Associates

Architects and Design Consultants

Quarry Cottages, Morley, Derby. DE7 6DJ. Telephone (0332) 882098

do not scale — check all dimensions

date sept. 25 — scale 1:100

drawing 740. B10 A.