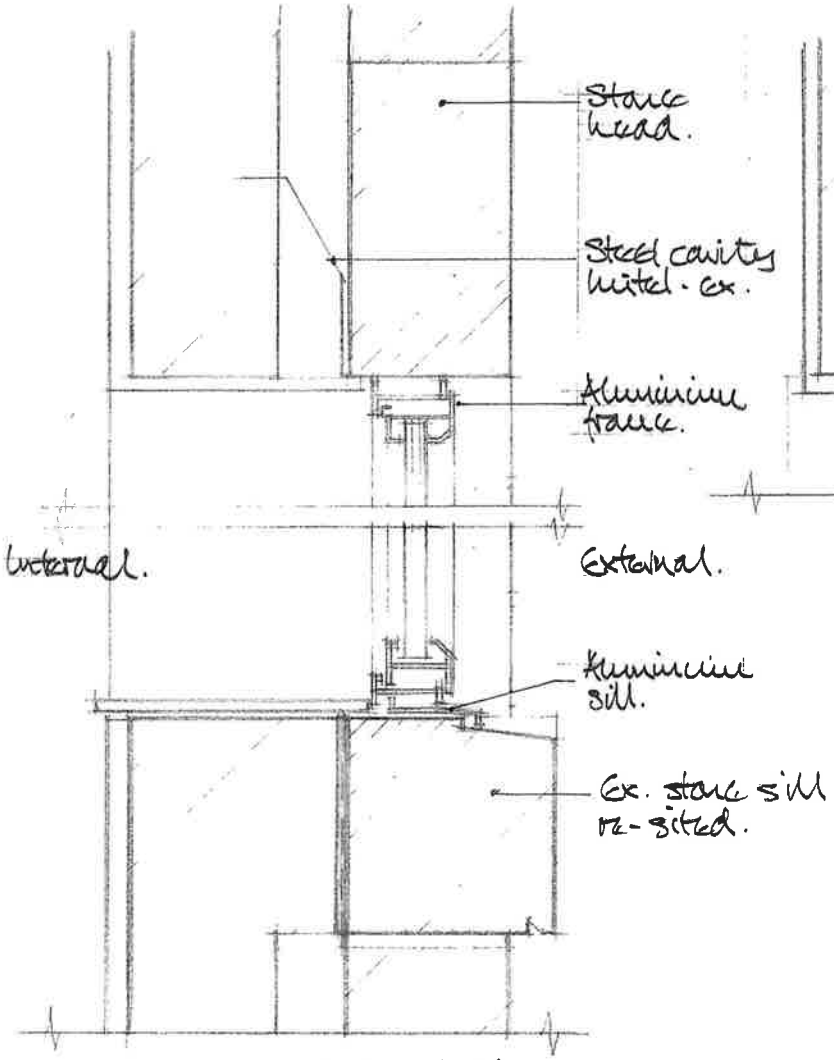

Head + Sill detail.
AS CONSTRUCTED. 1:5.

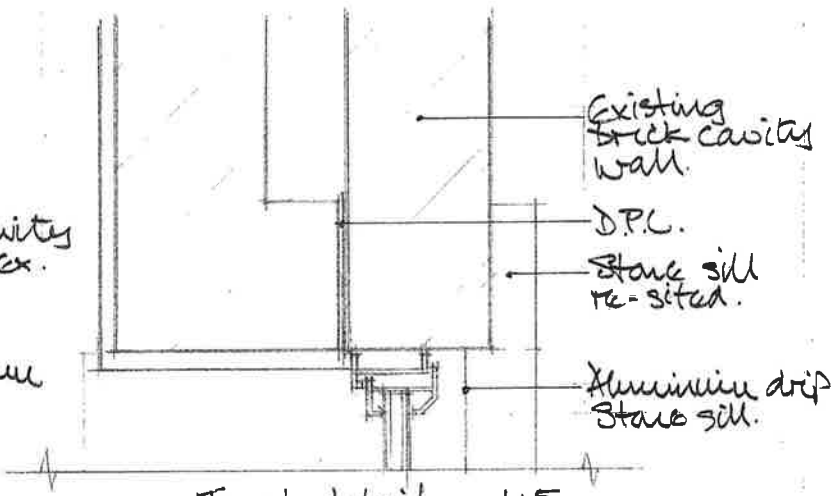

Jamb detail. 1:5.
AS CONSTRUCTED

Aluminium window + door details. 1:5.

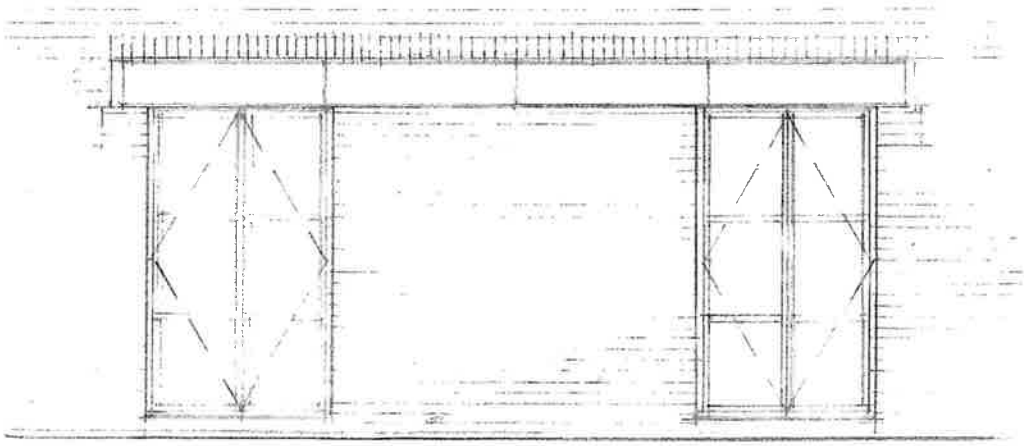

Elevation to steel beam cover. 1:50.
DESIGN BY THE CLIENT / BUILDER.

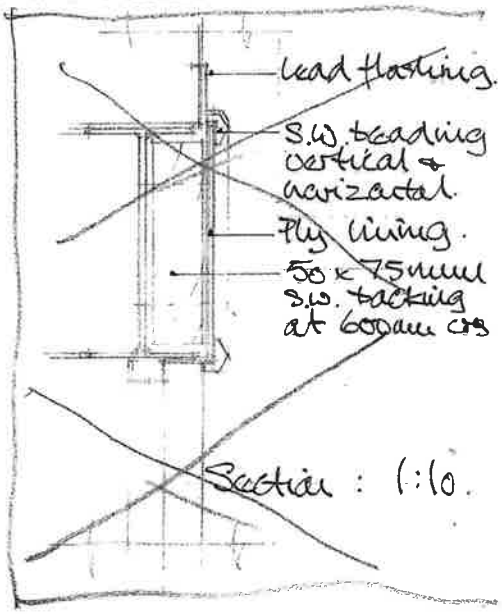

Window Sections.
Steel beam cover.

740.02.