
A3

AVA/2026/0026

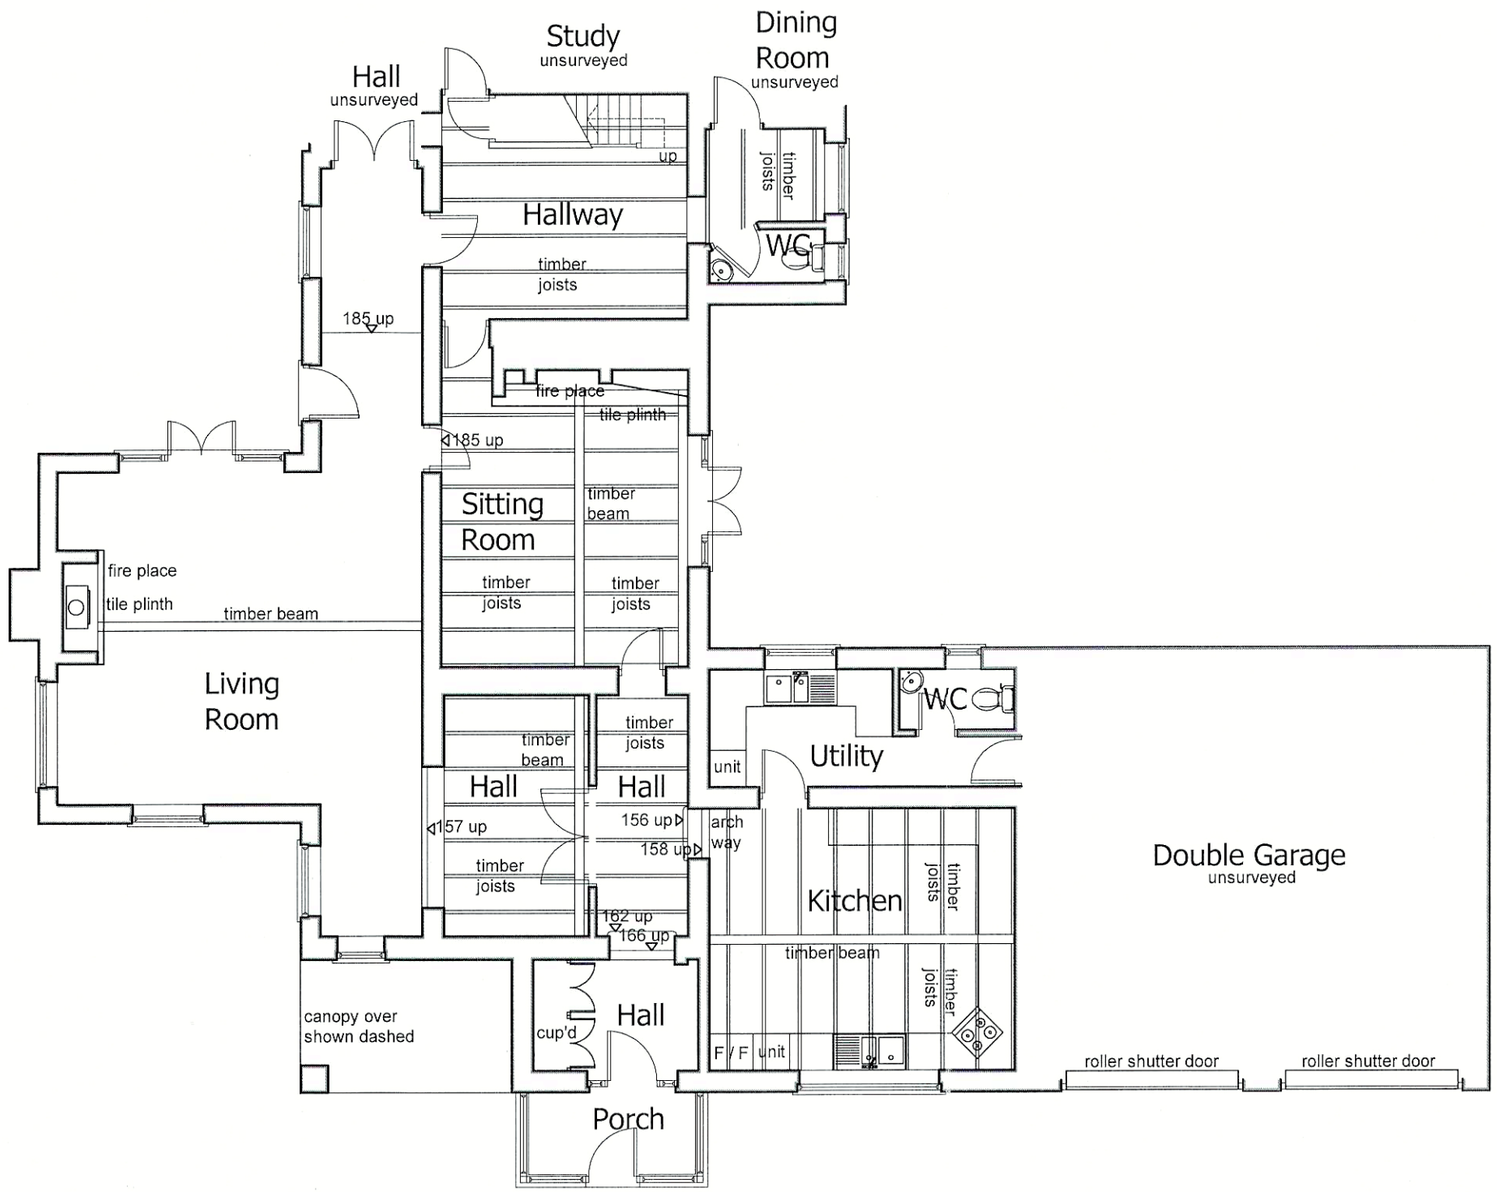

As Built Ground Floor Plan

Scale 1:100

Rev	By	Date	Details	Chkd
A	CW	26.01.26	Drawing Sheet Size and Drawing Scale Amended	

Drawing Status: For Planning

Construction Design Solutions

Consulting Civil, Structural, Highway & Drainage Engineers

78 Wollaton Road,
Beeston,
Nottingham.
NG9 2NZ.

Tel: 0115 922 9491
Fax: 0115 922 7451
General E-mail: design @ cdsconsulting . co . uk
Website: www . cdsconsulting . co . uk

Client: Mr Chris Romney

Project: Sycamore Farm, Old Road
Heage, Belper, DE56 2BN

Title: As Built Ground Floor Plan

Scale (A3) 1:100	Drawn by. CW	Drg. No. 2025-10977-02A
Date. January 2026	Checked by.	

Copyright of CDS