

South elevation.

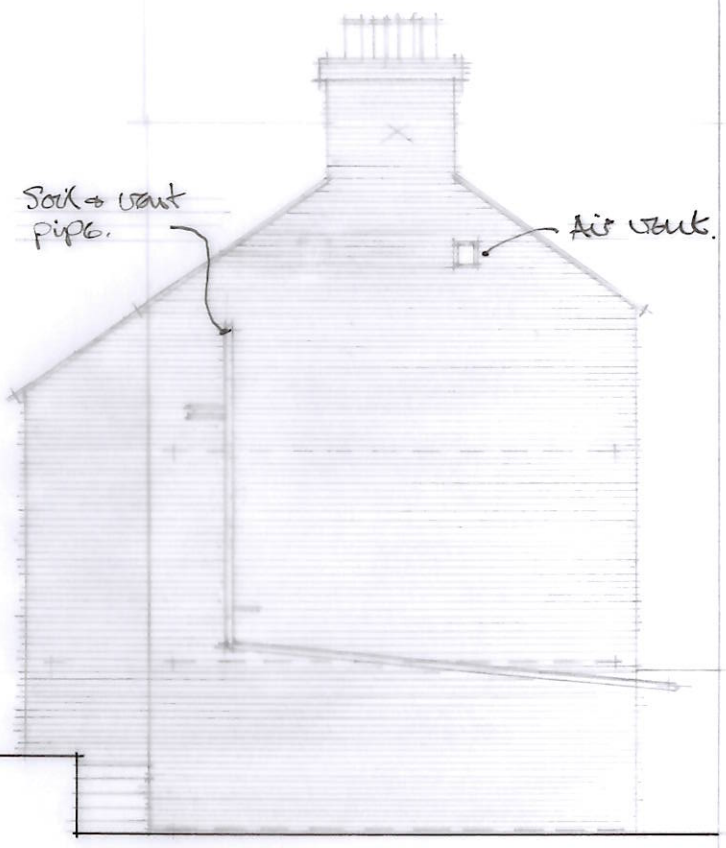

West elevation.

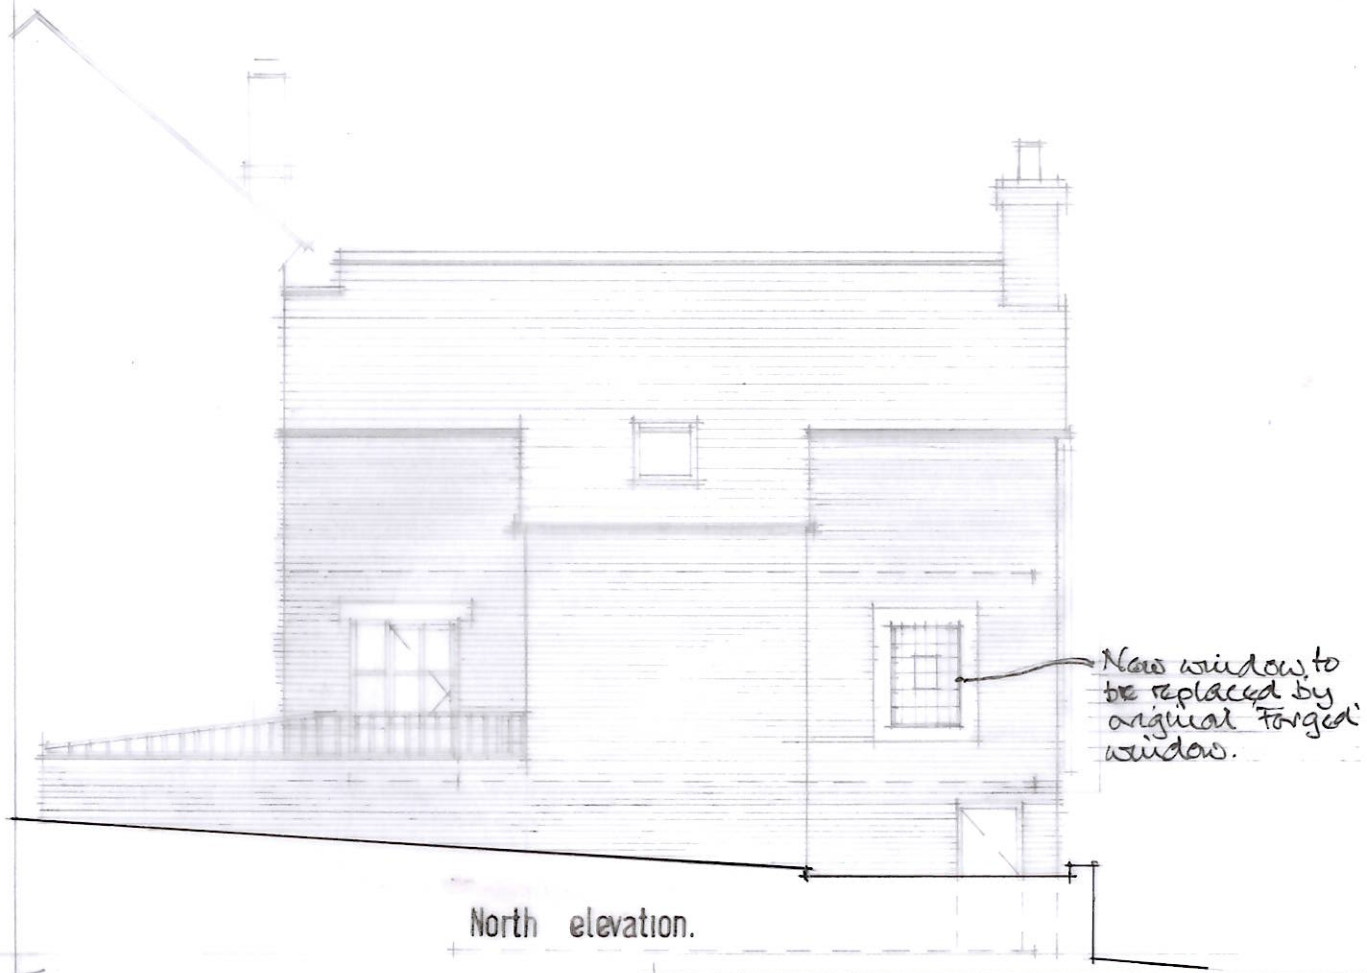

North elevation.

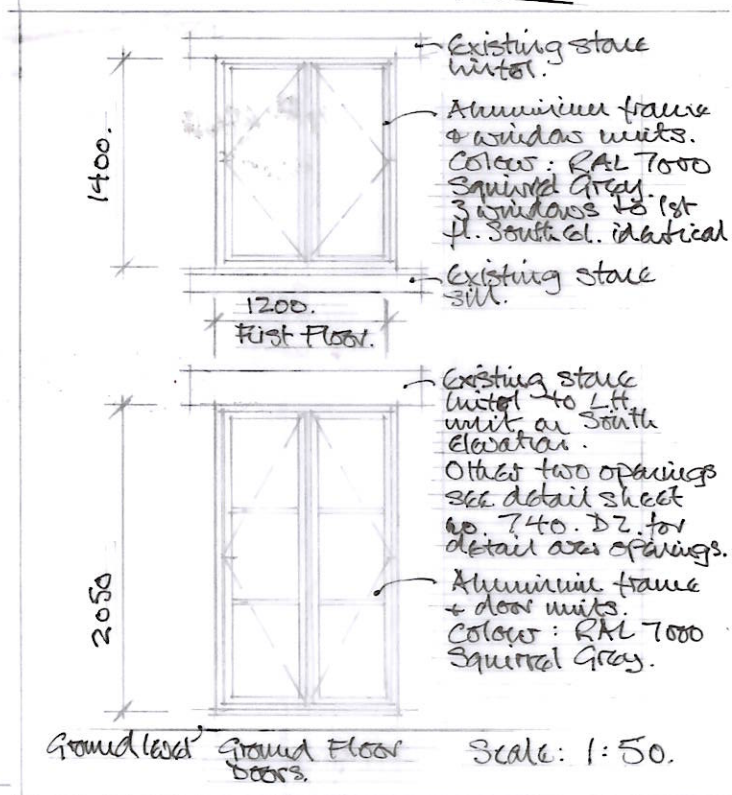

Scale: 1:50.

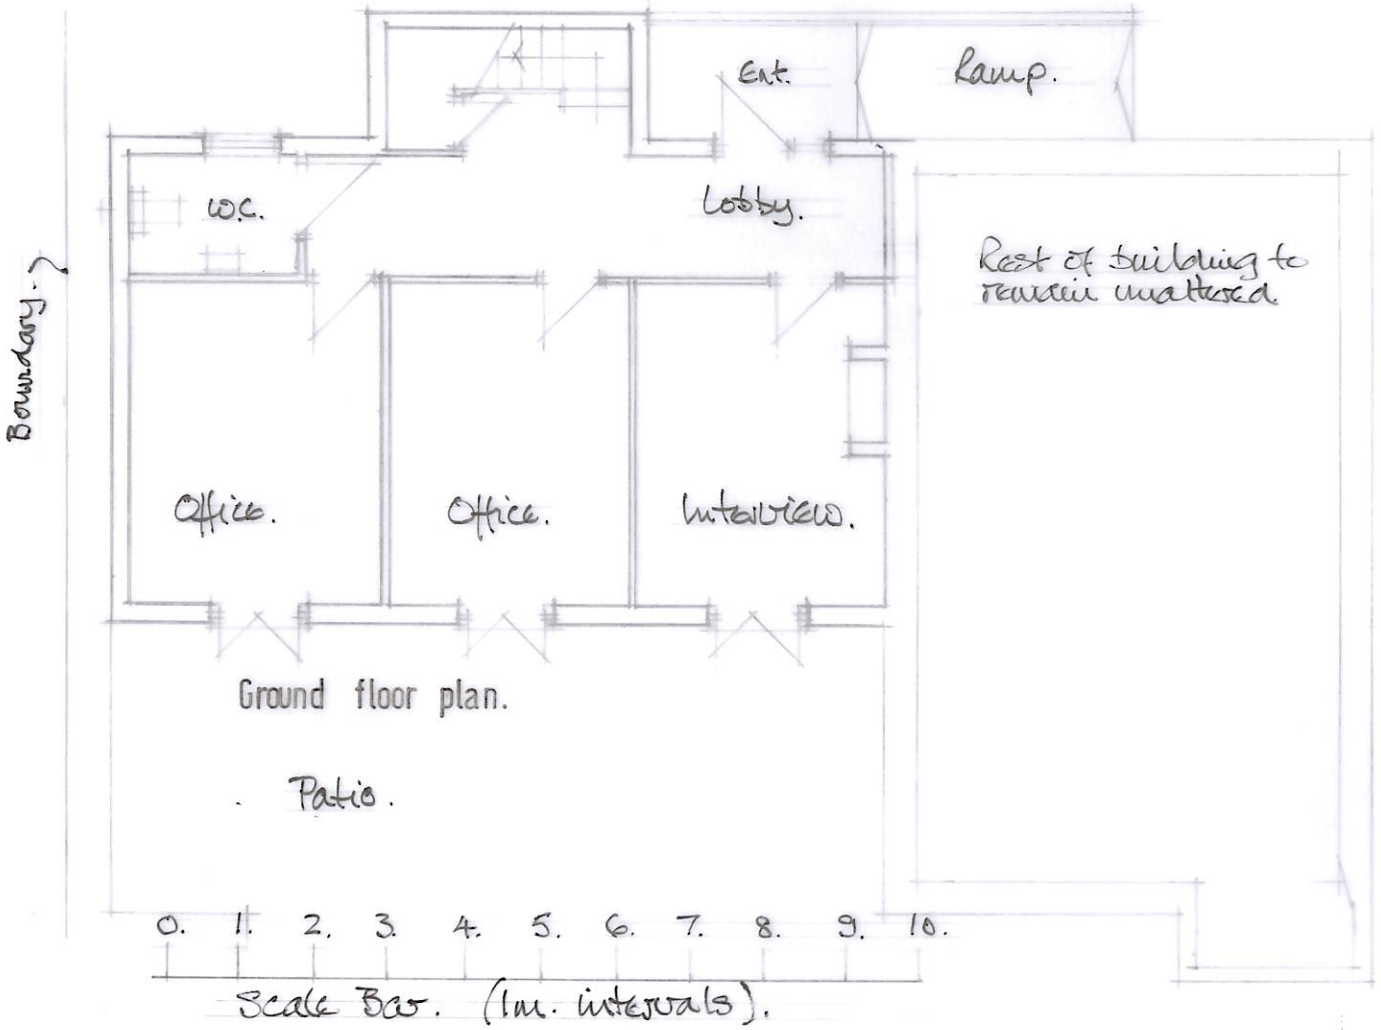

Ground floor plan.

Patio.

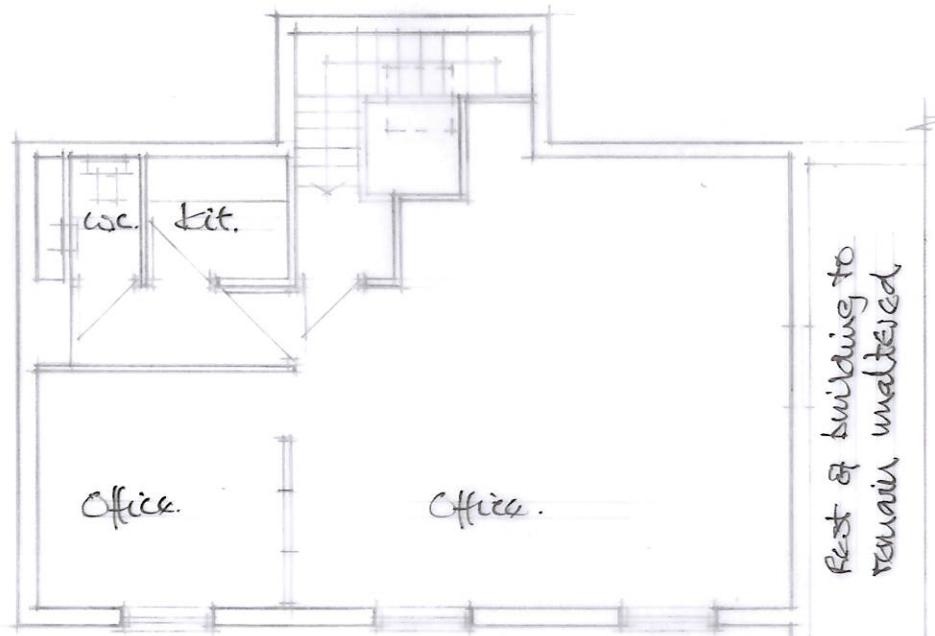

First floor plan.

North

Beam painted (3. elev)

B. 20.2.26 Existing forged window retained.

A 3.10.25 Windows + doors at 1:50 added. + detail over 2no doors.

project Proposed alterations, The Old School House, Green Lane, Belper.

client C. Jones.

As Constructed.

Swinfield Design Associates

Architects and Design Consultants

Quarry Cottages, Morley, Derby. DE7 6DJ. Telephone (0332) 882098

do not scale — check all dimensions

date sept. 25 — scale 1:100

drawing 740. B10 B.

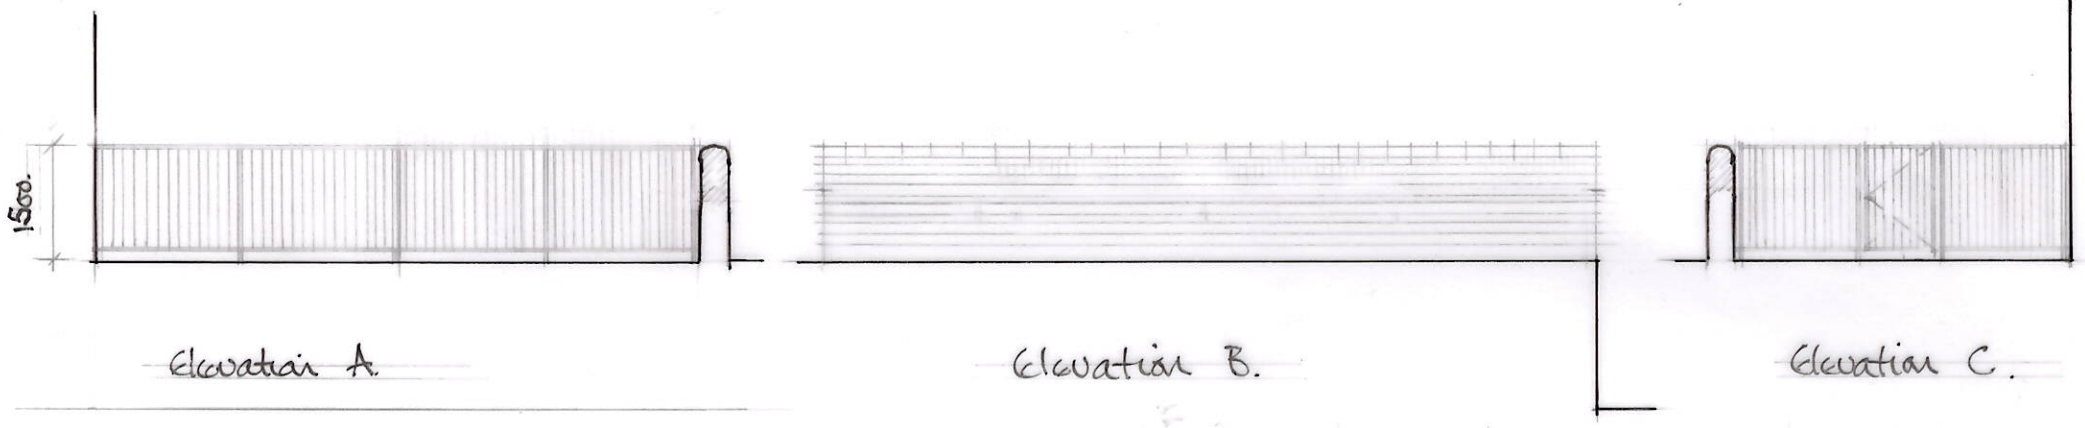

Elevation A.

Elevation B.

Elevation C.

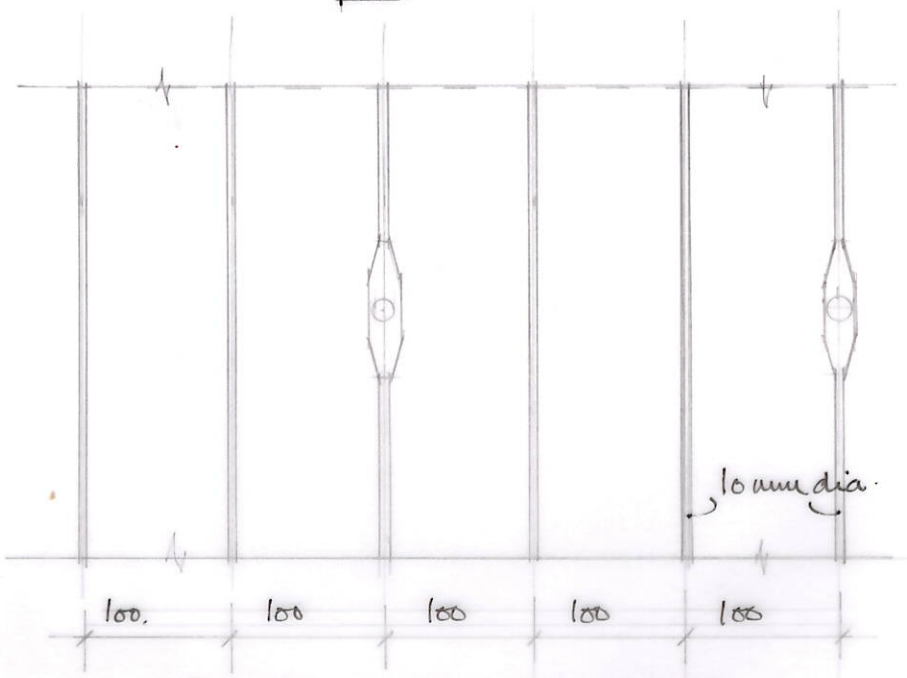

Detail of steel railings. 1:5.
Decorative rail every 300mm.

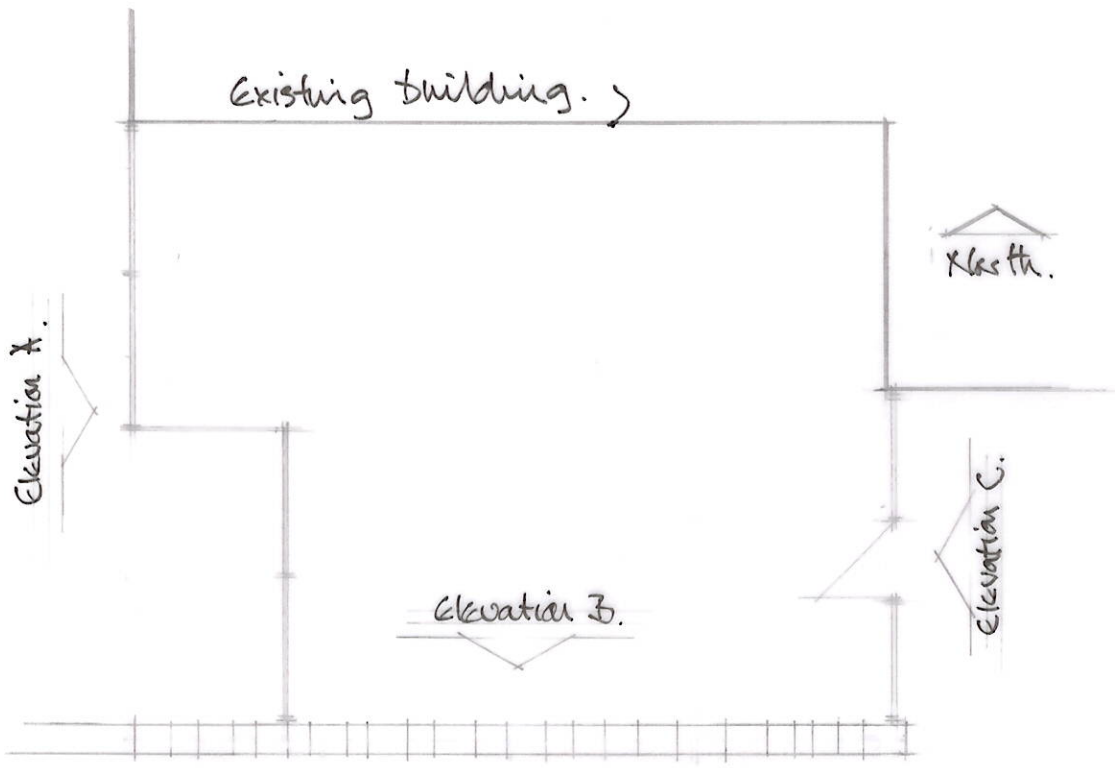

Plan of Patio Area. 1:100.

A.23.2.24 Steel railings lowered to 1500mm. Stone wall.

Steel Railings. 740. D3.A.