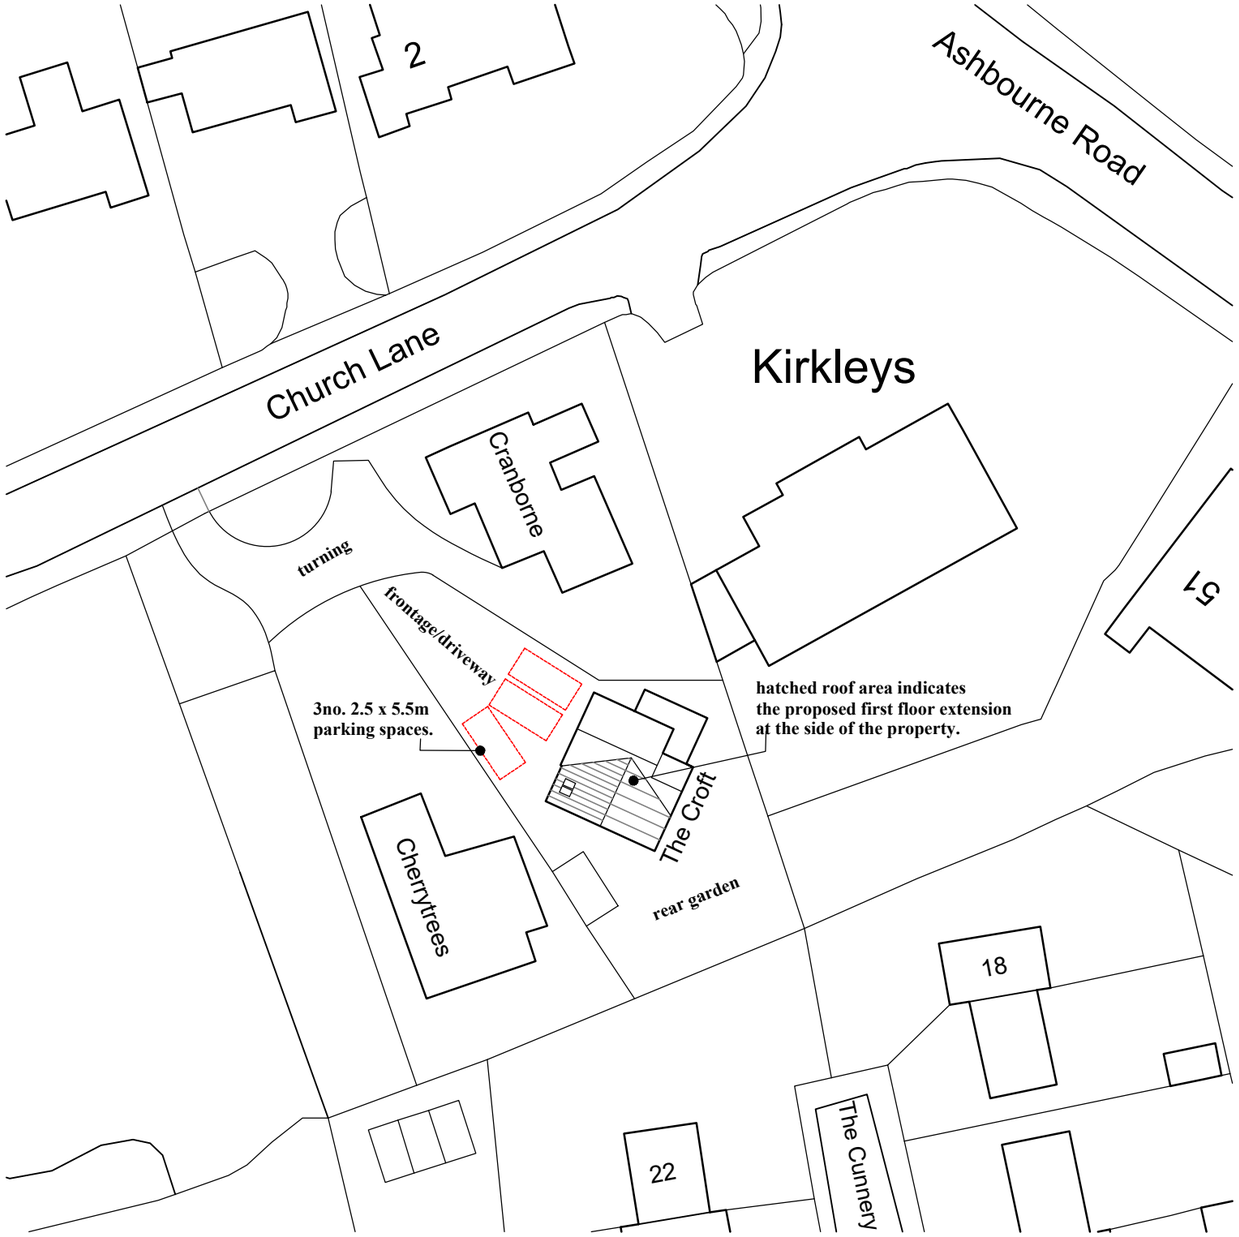

Proposed Site Plan - scale 1:500

N

UK Planning Maps

01856 898 022
www.UKPlanningMaps.com



Produced on 04 March 2026 from the Ordnance Survey National Geographic Database and incorporating surveyed revision available at this date.
This map shows the area bounded by 428685 338845,428785 338845,428785 338945,428685 338945,428685 338845
Crown copyright and database rights 2026 OS 100054135. Supplied by copla ltd trading as UKPlanningMaps.com a licensed Ordnance Survey partner (OS 100054135).
Data licence expires 04 March 2027. Unique plan reference: v1l//1386132/1857132

10 0 10 20 30 40 50

Location Plan - scale 1:250

Rev.A - Red line amended to show it connecting to highway on Location Plan and parking spaces added to site plan. 14.04.26

DERBY ARCHITECTURAL SERVICES

www.derbyarchitecturalservices.co.uk
Email: tristan@derbyarchitecturalservices.co.uk
Contact Number: 07810 565608

Client: **Mr & Mrs Bouwer**	Scale: 1:500 & 1:1250 @ A3
Job Add.: **The Croft, Church Lane, Kirk Langley. DE6 4NG**	Date: Mar 2026 / Rev: A
Dwg Title: **Proposed Site Plan & Location Plan**	Dwg No: 2026-03-19-02