
NOTES

- DO NOT SCALE OFF DRAWINGS.
- THIS IS AN A1 DRAWING. IF REPRODUCED IN ANY OTHER FORMAT THE SCALE SHOWN WILL BE INCORRECT.
- DO NOT SCALE OFF THIS DRAWING.
- ANY AMBIGUITIES, OMISSIONS AND ERRORS,OR INCONSISTENCIES WITH OTHER DOCUMENTS, ON THIS DRAWING SHOULD BE NOTIFIED IMMEDIATELY TO GREEN 2K DESIGN LTD BEFORE THE COMMENCEMENT OF WORKS ON SITE.
- ALL DIMENSIONS ARE IN MILLIMETRES UNLESS OTHERWISE STATED.
- ALL DIMENSIONS, UNLESS OTHERWISE STATED, ARE TO THE FACE OF UNFINISHED MASONRY WALLS OR TO THE FINISHED PLASTER FACE OF STUD PARTITIONS.
- ALL DIMENSIONS ARE TO BE CHECKED ON ANY DISCREPANCIES ARE TO BE NOTIFIED IMMEDIATELY TO GREEN 2K DESIGN LTD BEFORE THE COMMENCEMENT OF WORKS ON SITE.
- ALL LEVELS ARE IN METRES UNLESS OTHERWISE STATED.
- THIS DRAWING IS TO BE READ IN CONJUNCTION WITH ALL OTHER RELEVANT DRAWINGS AND SPECIFICATIONS FOR THIS PROJECT AND APPARENT INCONSISTENCIES BROUGHT TO THE ATTENTION OF GREEN 2K DESIGN LTD.
- DRAWING TO PRINTED IN FULL COLOUR.
- ALL MATERIALS SPECIFIED ARE TO BE USED STRICTLY IN ACCORDANCE WITH MANUFACTURERS RECOMMENDATIONS AND CODES OF PRACTICE.
- ALL ITEMS AND DETAILS WHICH ARE TO MATCH OR LINE UP ARE TO BE SITE MEASURED PRIOR TO SETTING OUT OR MANUFACTURE.

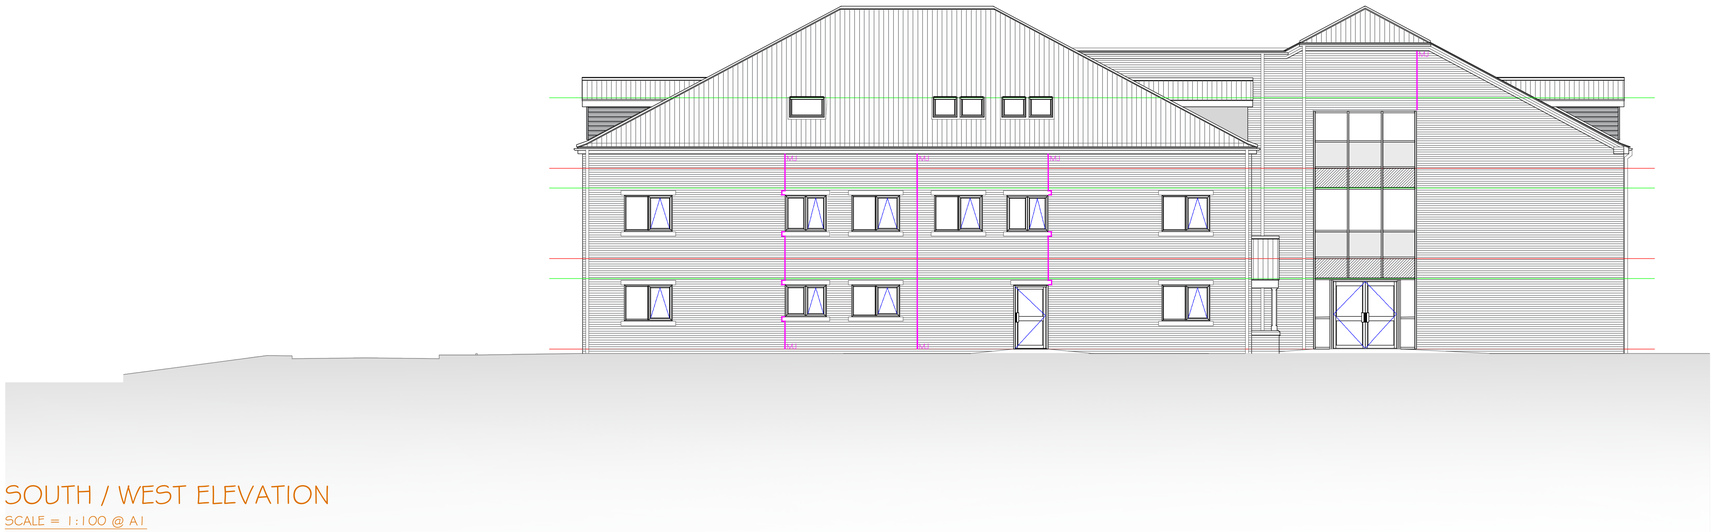

SOUTH / WEST ELEVATION

SCALE = 1:100 @ A1



SOUTH / EAST ELEVATION

SCALE = 1:100 @ A1

REV.	DATE.	INT.	DETAILS.

green2k design

Thomas Henry House, 1-5 Church Street,
Ripley, Derbyshire, DE5 3BU

t: 01773 512935 f: 0870 8362206
e: info@green2kdesign.com

Client
THREE PEAK DEVELOPMENTS

Project
HEANOR PARK CARE HOME

Drawing Title
AS BUILT GA ELEVATIONS SW & SE

Drawn: - TRW	Date: - OCT 2019
Job Status: -	'AS BUILT'
Job No: -	1362
Sheet No: - AB14	Rev . '-'
Scale: - 1:100 @ A1	