AS BUILT LAYOUT
SCALE 1:50



AS BUILT ELEVATIONS
SCALE 1:100

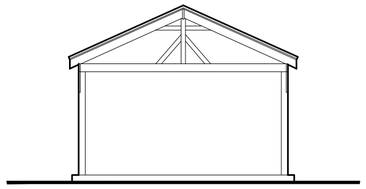

FRONT

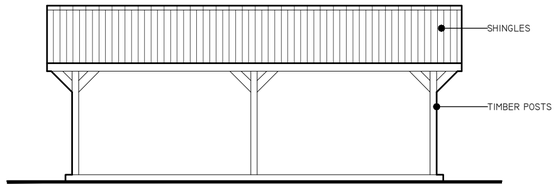

SIDE

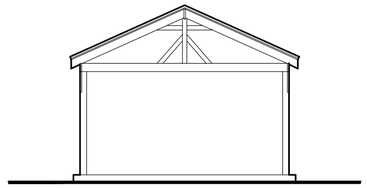

REAR

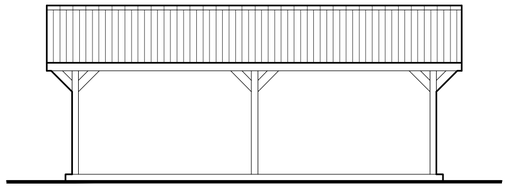

SIDE

ECOLOGY ENHANCEMENTS

PROPOSED SWIFT BIRD BOX - INBUILT INTO GABLE 6M OFF GROUND
HTTPS://HTTPS://IBSTOCKBRICK.CO.UK/KEVINGTON/ECO-PRODUCTS/
ECO HABITATS FOR SWIFTS INR IN TOTAL

© CROWN COPYRIGHT. ALL RIGHTS RESERVED. LICENSE NO. 100019980
OBTAINED FROM WWW.CENTREMAPSLIVE.COM

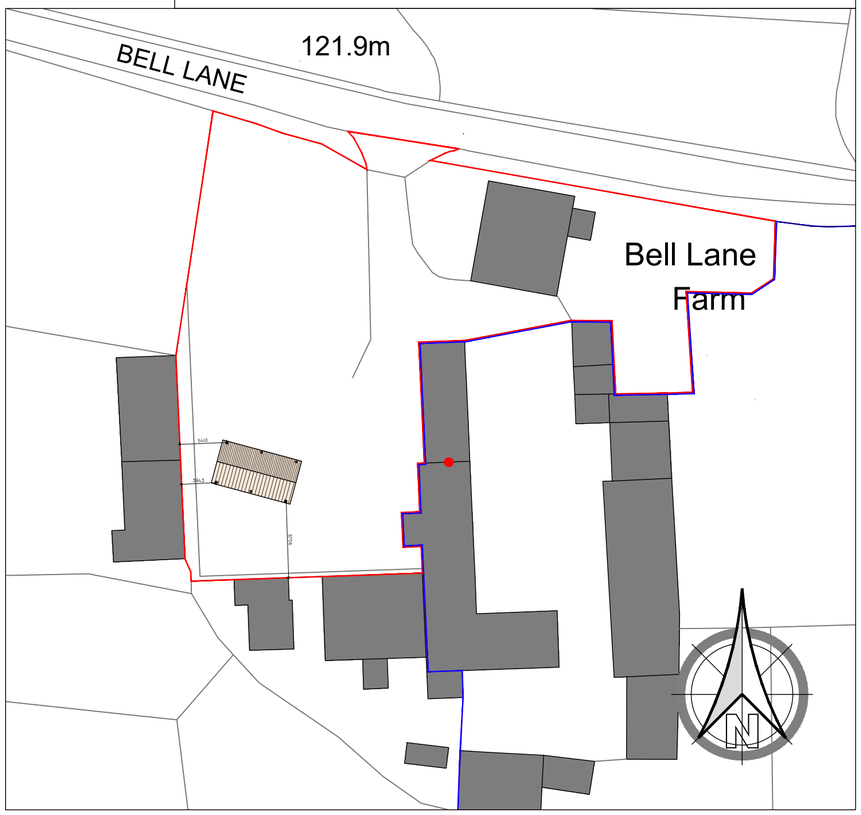

SITE BLOCK PLAN
SCALE 1:500

1:50 1M 2M 3M 4M 5M
1:100 2M 4M 6M 8M 10M
1:200 5M 10M 15M 20M
1:500 10M 20M 30M 40M 50M

REVISIONS

PAUL GAUGHAN
BUILDING CONSULTANTS

Unit E14, Langham Park Industrial Estate, Lows Lane
Stanton by Dale, Ilkeston DE7 4RJ
PHONE 0115 9324010
E-MAIL: INFO@PAUL-GAUGHAN.CO.UK
WEB: WWW.PAUL-GAUGHAN.CO.UK

CLIENT
-

LOCATION
BELL LANE FARM,
BELL LANE, SMALLEY,
DERBYSHIRE, DE7 6DU

PROJECT
RETROSPECTIVE PLANNING APPLICATION TO RETAIN DOMESTIC GAZEBO

TITLE
AS BUILT FLOOR PLAN, ELEVATIONS & SBP

PAPER SIZE	SCALE	DATE
ISO A2 (420.00 x 594.00 MM)	1:500, 1:100, 1:50	JUNE 2026

DRAWING NUMBER	REVISION
JG/RG/2026/275/01	A

SCALES ARE CORRECT AT TIME OF PLOTTING HOWEVER PLEASE NOTE THAT DISTORTION CAN OCCUR DURING COPYING. THIS DRAWING IS COPYRIGHT AND MAY NOT BE ALTERED, TRACED, PHOTOGRAPHED, ELECTRONICALLY COPIED OR USED FOR ANY PURPOSE OTHER THAN FOR WHICH IT IS ISSUED, WITHOUT WRITTEN PERMISSION.
CHECK ALL DIMENSIONS ON SITE. ANY DISCREPANCIES SHOULD BE REPORTED TO THE DESIGNER BEFORE WORKS PROCEED. HATCHING IS A REPRESENTATION OF MATERIALS ONLY.