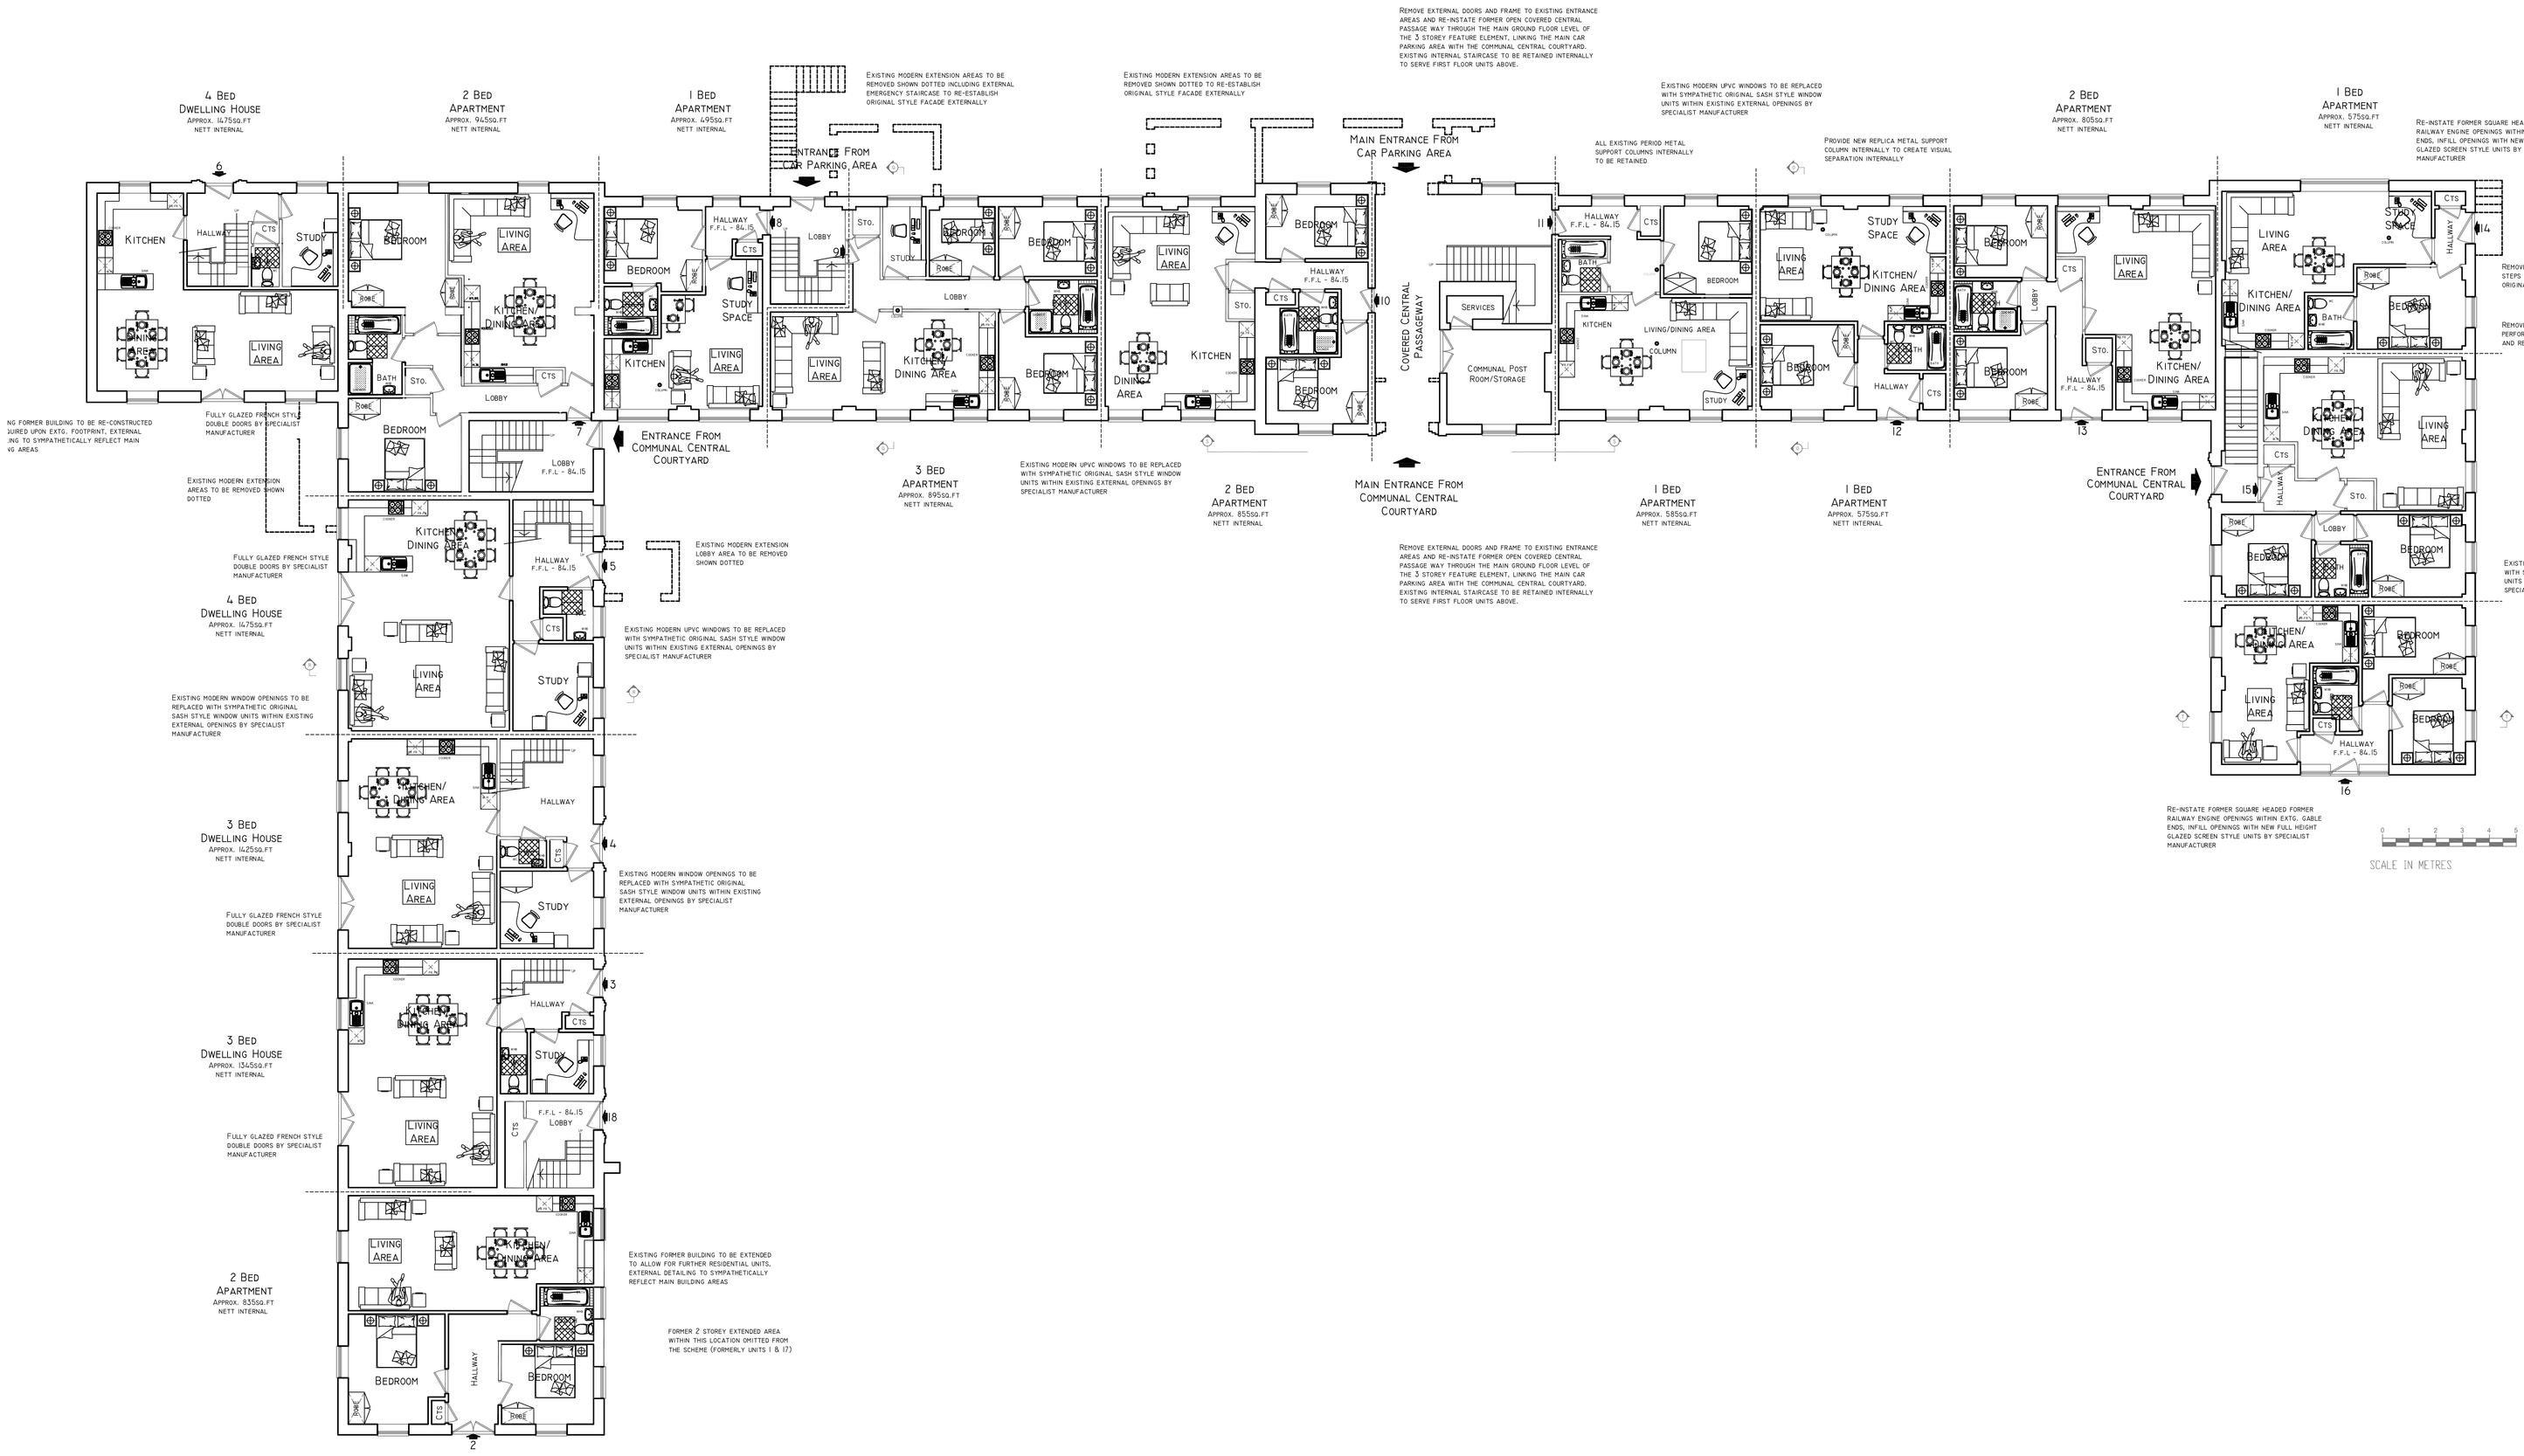


ARC DESIGN STUDIO

e hello@arcdesignstudio.co.uk w www.arcdesignstudio.co.uk

GENERAL NOTES

1. Do not scale off this drawing unless a scale bar is provided.
2. Any discrepancies between drawings and existing building should be notified immediately to the Architect before the commencement of works on site.
3. Dimensions are in millimetres unless otherwise stated.
4. Dimensions, unless otherwise stated, are to the face of unfinished block walls or to the finished plaster face of stud partitions.
5. Dimensions are to be checked on site. Discrepancies are to be notified immediately to the Architect before the commencement of works on site.
6. All levels are in meters unless otherwise stated.
7. This drawing is to be read in conjunction with all other relevant drawings and specifications for this project.

CDM REGULATIONS

⚠ **Denotes a significant hazard or difficult to manage procedure. Please refer to Designer Hazard Register for further information regarding mitigation of hazards.**

REVISION NOTES

Rev	Date	Description	Issuer	Checker
P01	23-07-26	Preliminary Issue For Client Comment	SD	EC
P02	03-08-26	Updated drawings issued following client feedback	EC	EC

DRAWING NOTES

The drawings shown have been produced by third party designers. Any adaptations to the original design are only suggestive and have been, "marked up", to illustrate to the client of the intended design changes as a route to compliance at RIBA Stage 4.

The proposed changes have been tracked following a review of Part B, M and K. Once the client has agreed the route to compliance, the design will be modelled in Revit and a set of RIBA Stage 4 GA layouts issued. As such, this set is not for construction and should only be used to illustrate design intent.

These drawings have been marked up on request of the client. Prior to any work being undertaken, written confirmation was obtained from the client to say that the previous design team had agreed for the information to be edited and that the client held the license covering adjustments made by ARC Design Studio.

PROJECT DIRECTOR Ewan Cassell

PROJECT LEAD Sude Dogan

PROJECT NAME Michael House School

PROJECT NO. 25-0013

PROJECT ADDRESS The Field, Shipley Park, Derbyshire, DE75 7JH

CLIENT / USER NAME Red Eagle One (Shipley) Ltd

SHEET NAME Proposed Level 00 Plan

FULL DOCUMENT REFERENCE

Identification / Location | Sheet Number

Project Code | Originator Code | Functional Breakdown | Spatial Breakdown | Doc. Form | Role /Dis | Sequential Number

MHS - ARC - GA - A00 - D - A - 3501

REVISION DATE 03-08-26

REVISION P02

STATUS PRELIMINARY

SHEET SIZE A0 L

SCALE

© ARCDSGN LIMITED [0328] 13118101 | ARC Space, Western House, Nottingham, NG1 5AZ