NOTES:
Copyright of this drawing belongs to Architectural Building Design Services (ABDS) and no part may be reproduced or utilised in any way whatsoever without prior written consent of ABDS.
Figured dimensions shall be taken in preference to scaled dimensions and any discrepancies or errors are to be referred to the designer.
Contractor, sub-contractor and suppliers must verify all dimensions on site before commencing work or making any fabrication drawings.
All elements such as structural walls, beams etc are to be checked on site for suitability prior to works undertaken.
All drawings to be read in conjunction with each other and all notes / building regulation specification, energy calculations, structural calculations / design and other professional / consultation documents associated with the project.

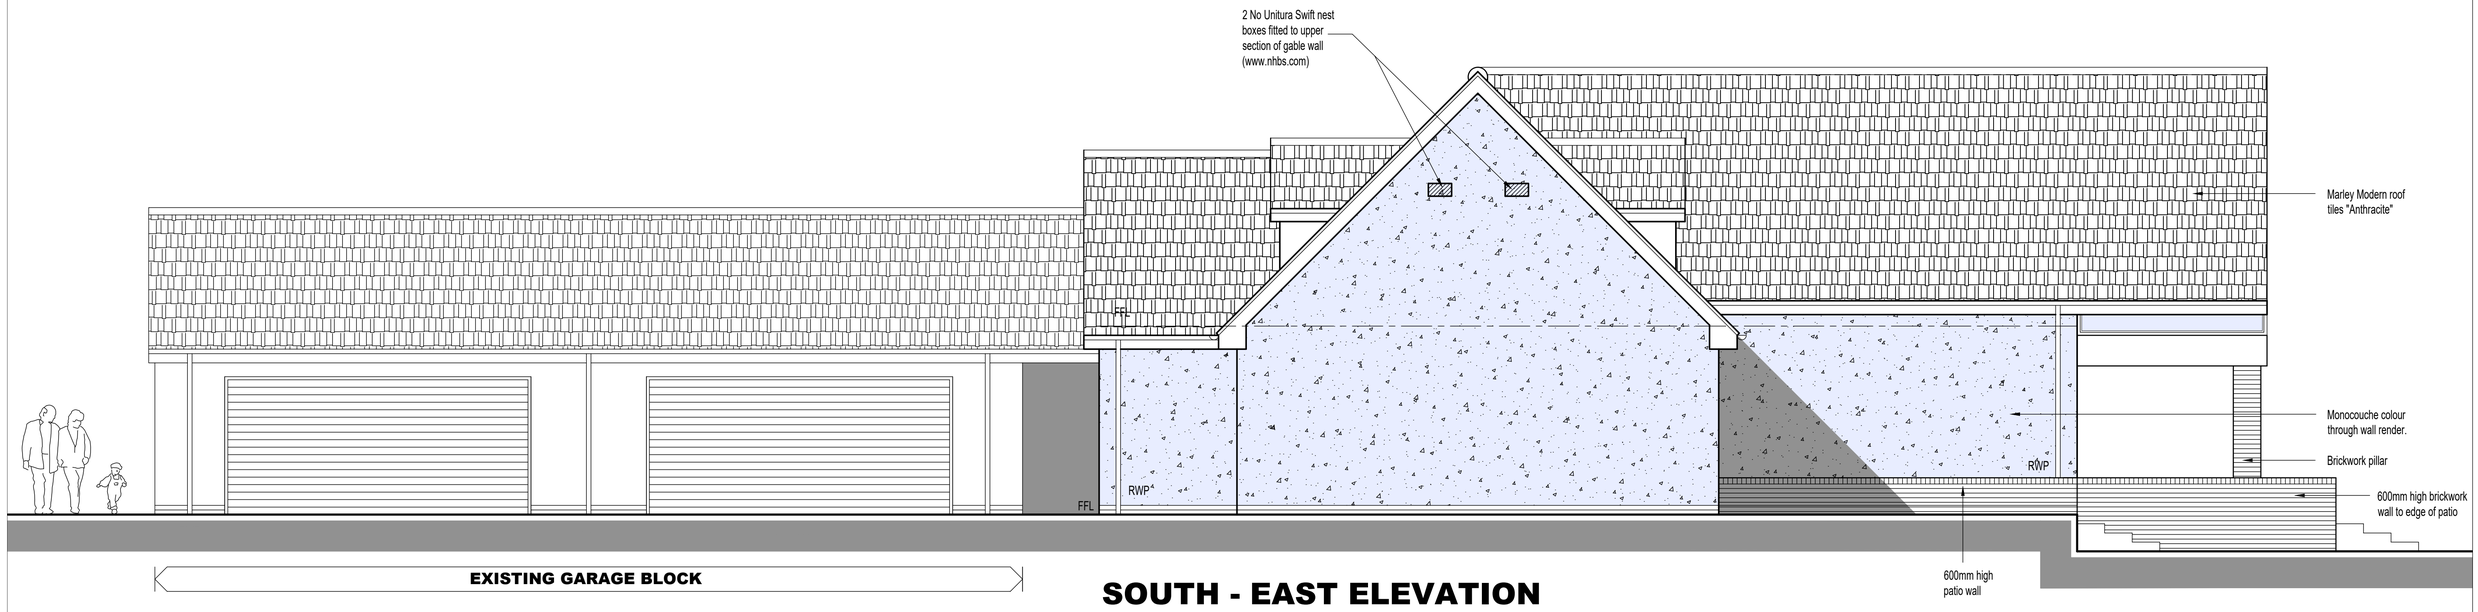

SOUTH - EAST ELEVATION

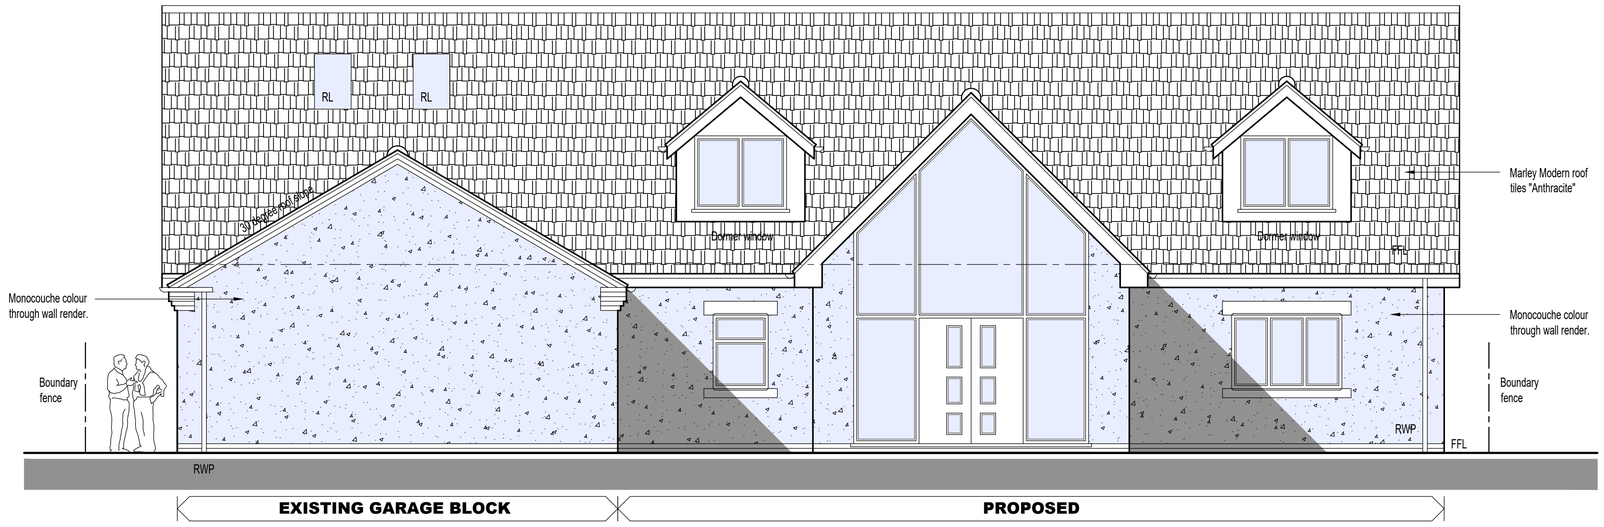

SOUTH - WEST ELEVATION

REV:	DATE:	DESCRIPTION:	BY:
D	15/10/26	2 No Swift nesting boxes shown to gable of south-east elevation.	CF
C	25/06/26	Drawing updated to suit as built.	CF
B	17/02/24	South-East elevation updated.	CF
A	04/03/22	South-East elevation roof overhang updated. Roof tile specified.	CF

ABDS
Architectural Building Design Services
Tel: 07773 899 597
E-mail: abds@abds.biz Web Site: www.abds.biz

PROJECT:
REPLACEMENT DWELLING

DRAWING TITLE:
PROPOSED ELEVATIONS (1 of 2)

PROJECT ADDRESS:
504 CROMFORD ROAD
WOODLINKIN
LANGLEY MILL. NG16 4HE

CLIENT:
Mr and Mrs Goddard

DATE: September 2021 SCALE: 1:50 FORMAT: A1

DRAWN: CF
CHECKED:
APPROVED:

DRG NO: 1828 / 28 2025 ©
This drawing is copyright of Architectural Building Design Services & cannot be reproduced without written concent

REVISION: D
Actual Size
0 10mm